IREDELL COUNTY HEALTH DEPARTMENT

STATESVILLE 704-878-5305 MOORESVILLE 704-664-5281

IMPROVEMENT PERMIT / AUTHORIZATION TO CONSTRUCT / OPERATION PERMIT / EXISTING SYSTEM INSPECTION

PERMIT# 125054 PIN# 4624360546 DATE 2-29-08

OWNER OR APPLICANT Warren Smith COURTLAND HOMES PHONE: Business (704) 363-1622 Home 704 658-1723 Rollans Env.

ADDRESS P.O. Box 3190, Mooresville NC 28117

LOCATION Brawley School Rd TR Bunker Way on left

SUBDIVISION The Point BLOCK / SECTION 10 LOT 1008 LOT AREA 1.68 Acres SITE CLASS PS DESIGN FLOW 480gpd L.T.A.R. .3

Septic Tank: 1000/1500 Gallons; STB 390 Date 4/23/08

Pump Tank: 1000 Gallons; PT 363 Date 6/25/08

Pump Make: Goulds Model WE0-312MH Serial No.

Nitrification Field: No Fields 1 Square Feet 840 Linear Feet 280

No Lines 4 Trench Width ~~See Note~~ Max Trench Bottom Depth 36

☒ New System ☐ Repair ☐ Expansion System Type: I II III IV V VI

System Description: Pump-Up-Panel Blk

Repair System Description: Same

Maintenance Agreement Required: ☒ Yes ☐ No

☒ House/Mod. Home No. Bedrooms 4

☐ Mobile Home No. Persons

☐ Business No. Employees

☐ Other


Water Supply: ☐ Individual ☒ Public ☒ Community

Gravel Depth N/A ☐ Gravity ☒ Pressure ☐ Slab ☐ Crawl Space ☒ Basement w/plumbing ☐ Basement wo/plumbing

Comments/Conditions: Scale 1:50 - ☆ Unfinished Basement PL 282.37

Comments/Conditions: Note: Use trench width as specified in Plan by Rollans Environmental (attached) ☆ Keep Drainlines 25ft From Storm Drain which is in Center of Drainage Easement.

INITIAL SITE SKETCH

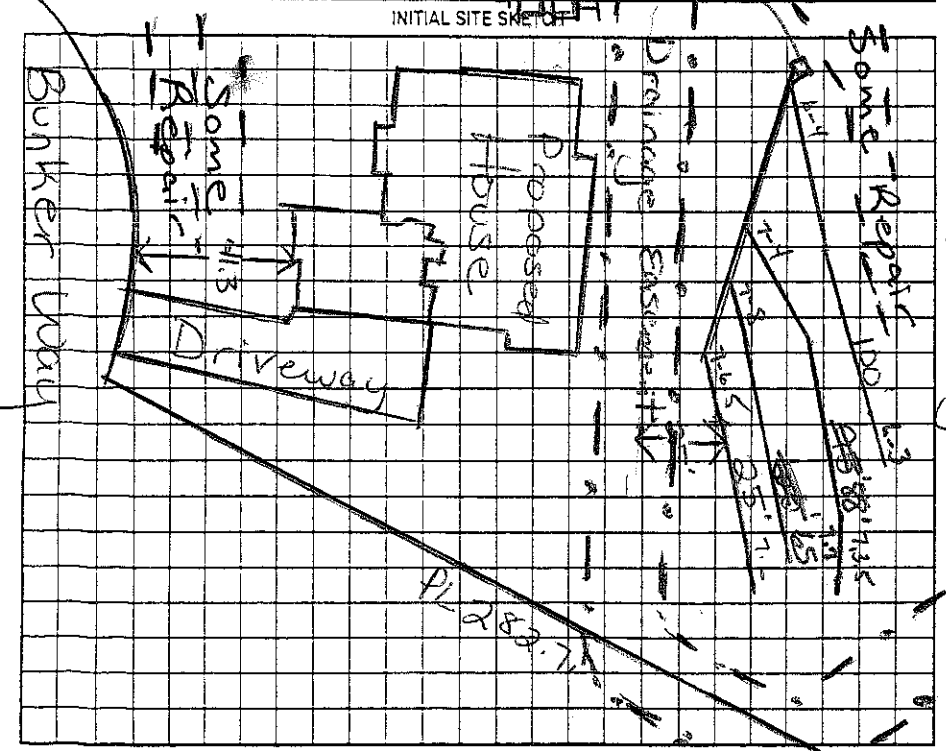

AS BUILT SKETCH

3/14/08 Reviewed Floor plans, in Compliance with original permit

Pressure Tanks, Lines, Control Box

Combined With Lot # 1009 See App. Card

System Expanded

See Permit 165458

Permit can be suspended or revoked if any false information is supplied toward securing the permit, any unauthorized changes are made to the site/any unauthorized changes are made in the installation of the system. Improvement Permit with plat valid without expiration ☐ Improvement Permit with site plan valid for sixty months ☐ Authorization to Construct is valid for a period equal to that of Improvement Permit – not to exceed sixty months.

Signed: _____ date _____ Installed by: Stanley Septic

Improvement Permit by: Marie H. Rollans RS date 2/29/08 Operation Permit by: Wesley Sparks RS date 5/24/08

Authorization to Construct by: Marie H. Rollans RS date 3/14/08 Existing System Inspection by: _____ date _____

HEALTH DEPT. COPY: WHITE OWNER COPY (FINAL): YELLOW OWNER COPY (INITIAL): PINK