3160

IREDELL COUNTY HEALTH DEPARTMENT

STATESVILLE 704-878-5305 MOORESVILLE 704-664-5281

IMPROVEMENT PERMIT / AUTHORIZATION TO CONSTRUCT / OPERATION PERMIT / EXISTING SYSTEM INSPECTION

PERMIT # 164424 PIN # 4624 36 0636 DATE December 9, 2010

OWNER or APPLICANT Matthew & Christie Heckler PHONE: Business 704-746-6497 Brady Home: 704-360-4640

OWNER or APPLICANT ADDRESS 112 Bunker Way Mooresville NC 28117

LOCATION / DIRECTIONS Brawley School Rd TR Bunker Way on left

SUBDIVISION The Point BLOCK / SECTION 10 LOT # 1008 LOT AREA 1.872Ac. DESIGN FLOW 240gpd L.T.A.R. .25 gpd/ft²

Septic Tank ~~1000~~ Gallons: STB 1000 Date 4-13-11

Pump Tank 1000 Gallons: PT 363 Date ≥ 28day

Pump Make Goulds Model WE0312 Serial #

Nitrification Field No Fields 1 No Lines 3 Linear Feet 240

Trench Width 36" Max. Trench Bottom Depth 36" Gravel Depth N/A ☐ GRAVITY ☒ PRESSURE

☒ New System ☐ Repair ☐ Expansion System Type I II (III) IV V VI

System Description: 25% Reduction Pump pm

Repair System Description: 25% Reduction Pump pm

Maintenance Agreement Required ☐ YES ☒ NO

☐ Residence No. Bedrooms 2

☐ Business No. Persons 4

☒ Other * No. Employees

☐ Slab ☒ Crawl Space

☐ Basement w/plumbing ☐ Basement w/o plumbing

Water Supply: ☐ Private ☐ Public ☒ Community

Comments / Conditions

PT reused

Comments / Conditions * Pool Cabana

Installed ADS 36 Plastic Chambers as Drawn, 10FT off PL.

INITIAL SITE SKETCH

See Plan from Michael Athanas & Assoc. Approved by ECHD

AS BUILT SKETCH

5/26/11 Checked tanks & lines
6/28/11 pressure set Elect & alarm

Permit can be suspended or revoked if any false information is supplied toward securing the permit / any unauthorized changes are made to the site / any unauthorized changes are made in the installation of the system.

☐ IMPROVEMENT PERMIT w / plan valid without expiration ☒ IMPROVEMENT PERMIT w / site plan valid for 60 mos. ☐ AUTHORIZATION TO CONSTRUCT valid for period equal to IMPROVEMENT PERMIT-not to exceed 60 mo.

Owner / Applicant Signature: [signature] Date 12-10-10

Improvement Permit by: Judy Melville REHS Date 12-9-10

Authorzation to Construct by: Judy Melville REHS Date 12-9-10


YOU SHOULD CONTACT A LOCATOR SERVICE PRIOR TO ANY EXCAVATION.

Installed by: R&H RS

Operation Permit by: [signature] Date: 6/28/11

Existing System Inspected by: Date:

WHITE COPY Environmental Health YELLOW COPY (Final) Owner / Applicant PINK COPY (Initial) Owner / Applicant

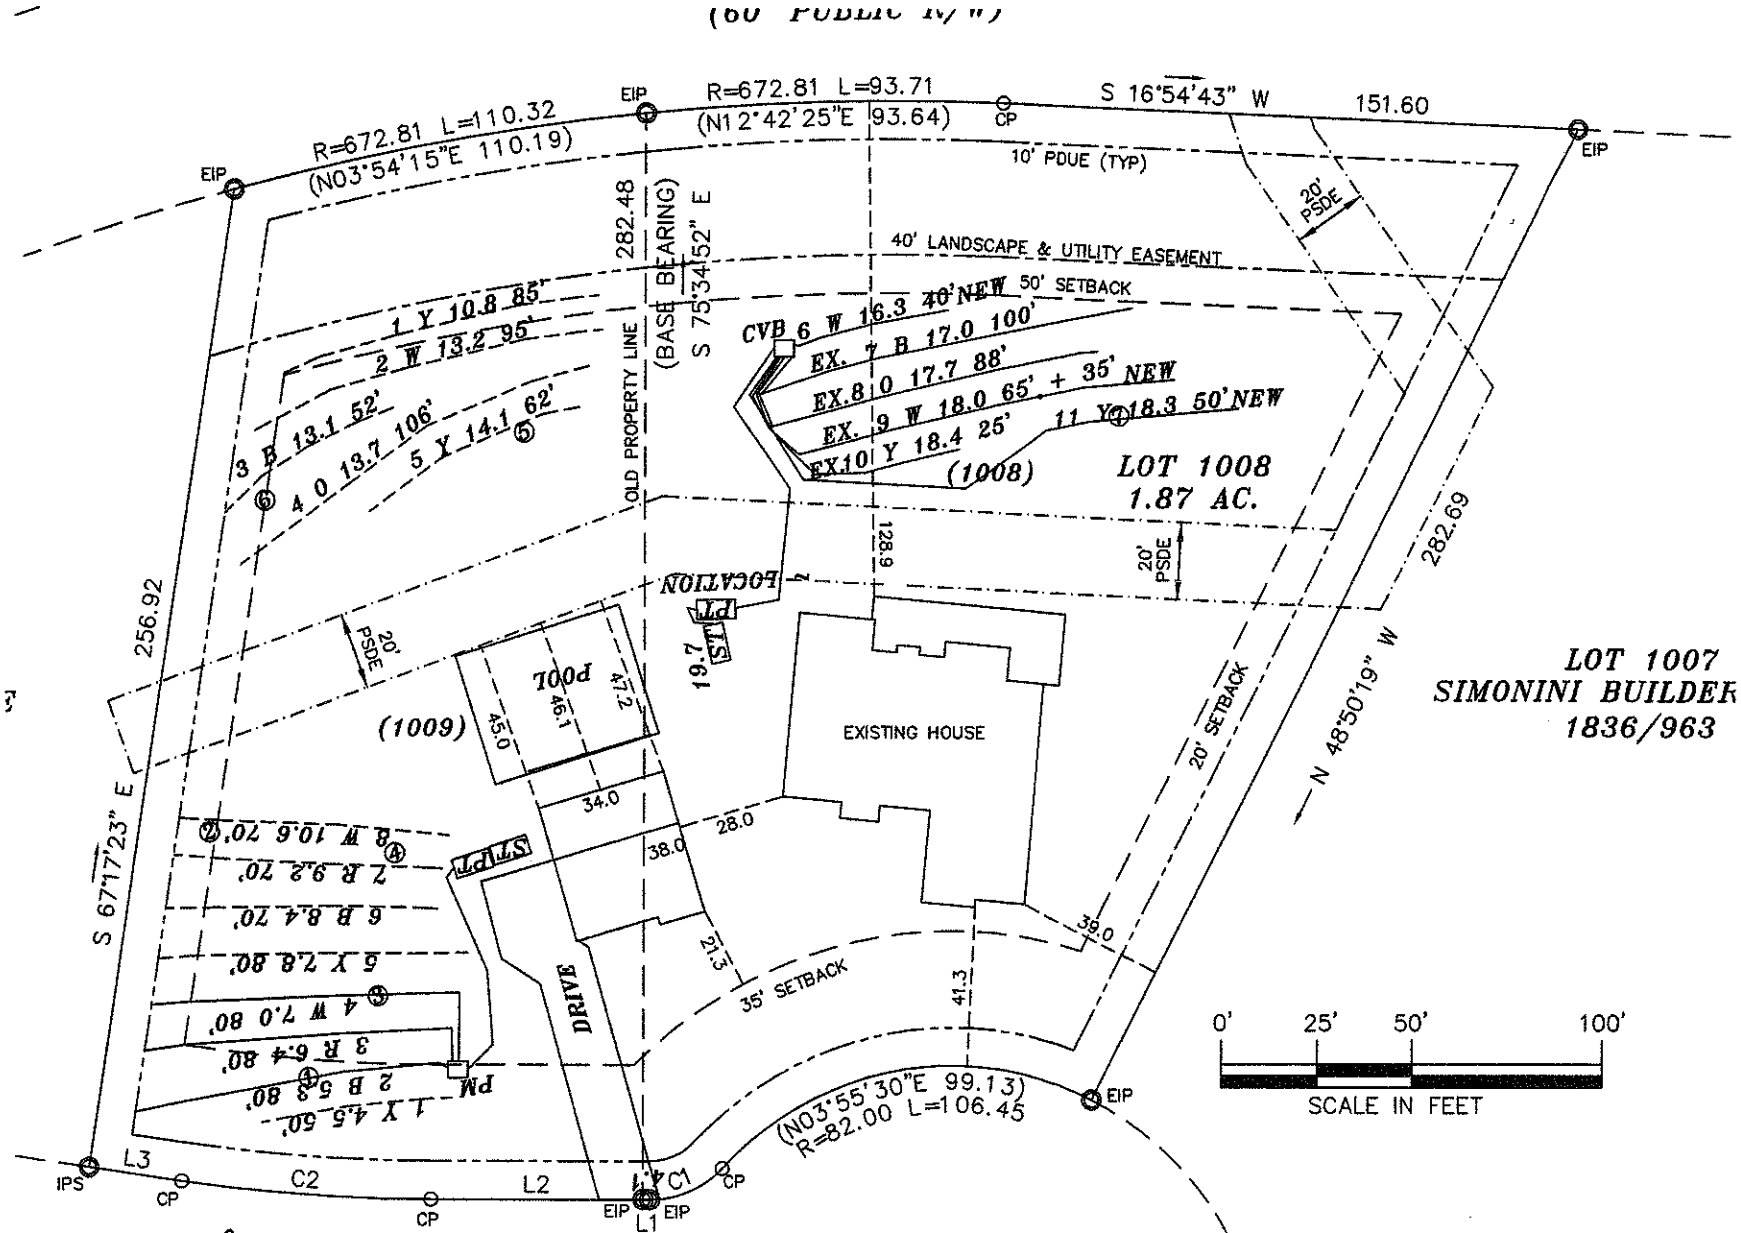

Approved ICHD
12-8-10
gm