IREDELL COUNTY HEALTH DEPARTMENT

Statesville Office (704) 878-5305 | Mooresville Office (704) 660-3625 | Old # 125057 | PERMIT # 210653

IMPROVEMENT PERMIT / AUTHORIZATION TO CONSTRUCT / OPERATION PERMIT / EXISTING SYSTEM

PIN # 4624-36-0879

APPLICANT: CLAUDE & LUCIA VERVILLE | APPLICANT ADDRESS: 111 BUNKER WAY - Mooresville

SITE ADDRESS: SAME | PHONE: 704-578-495 ALT. PHONE: → KATHLEEN SAUNDERS

SITE DIRECTIONS: BSR, TR BUNKER WAY, ON L

SUBDIVISION: THE POINT ON NORMAN | SECTION: 10 | LOT # 1010 | LOT AREA: .924 AC | DESIGN FLOW: 480 | L.T.A.R.: .5

Septic Tank	1500 (gal)	STB	Date	☑ New System	☐ Repair	☐ Expansion	System Type: I II III (IV) V VI
Pump Tank	1000 (gal)	PT	Date	System Description:	LP PANEL BLOCK		
Pump Make	Drenfo Model	PF300511	Serial #	Repair System Description:	SAME		
# Nitrification Fields	1 # Lines	3	Linear Ft: 270'	Maintenance Agreement Required:	☑ YES	☐ NO	
Trench Width	36" Max. Trench Bottom Depth	30"	Gravel Depth —		☐ GRAVITY	☒ PRESSURE	

☑ Residence — No. Bedrooms: 4
☐ Business — No. Persons:
☐ Other — No. Employees:
☐ Slab — ☑ Crawl Space
☐ Basement w/plumbing — ☐ Basement w/o plumbing

Water Supply: ☐ Private ☐ Public ☒ Community

Comments / Conditions:

CHECKED TANKS 2-19-16 INSTALLED WHERE SHOWN
RA
CHECKED LINES & CVB 2-22-16
Set pressure, elect. & alarm MS
4/8/16

INITIAL SITE SKETCH

SEE PLAN FROM KATHLEEN SAUNDERS

AS BUILT SKETCH

Permit can be suspended or revoked if any false information is supplied toward securing the permit / any unauthorized changes are made to the site / any unauthorized changes are made in the installation of the system. **CONTACT A LOCATOR SERVICE PRIOR TO ANY EXCAVATION**

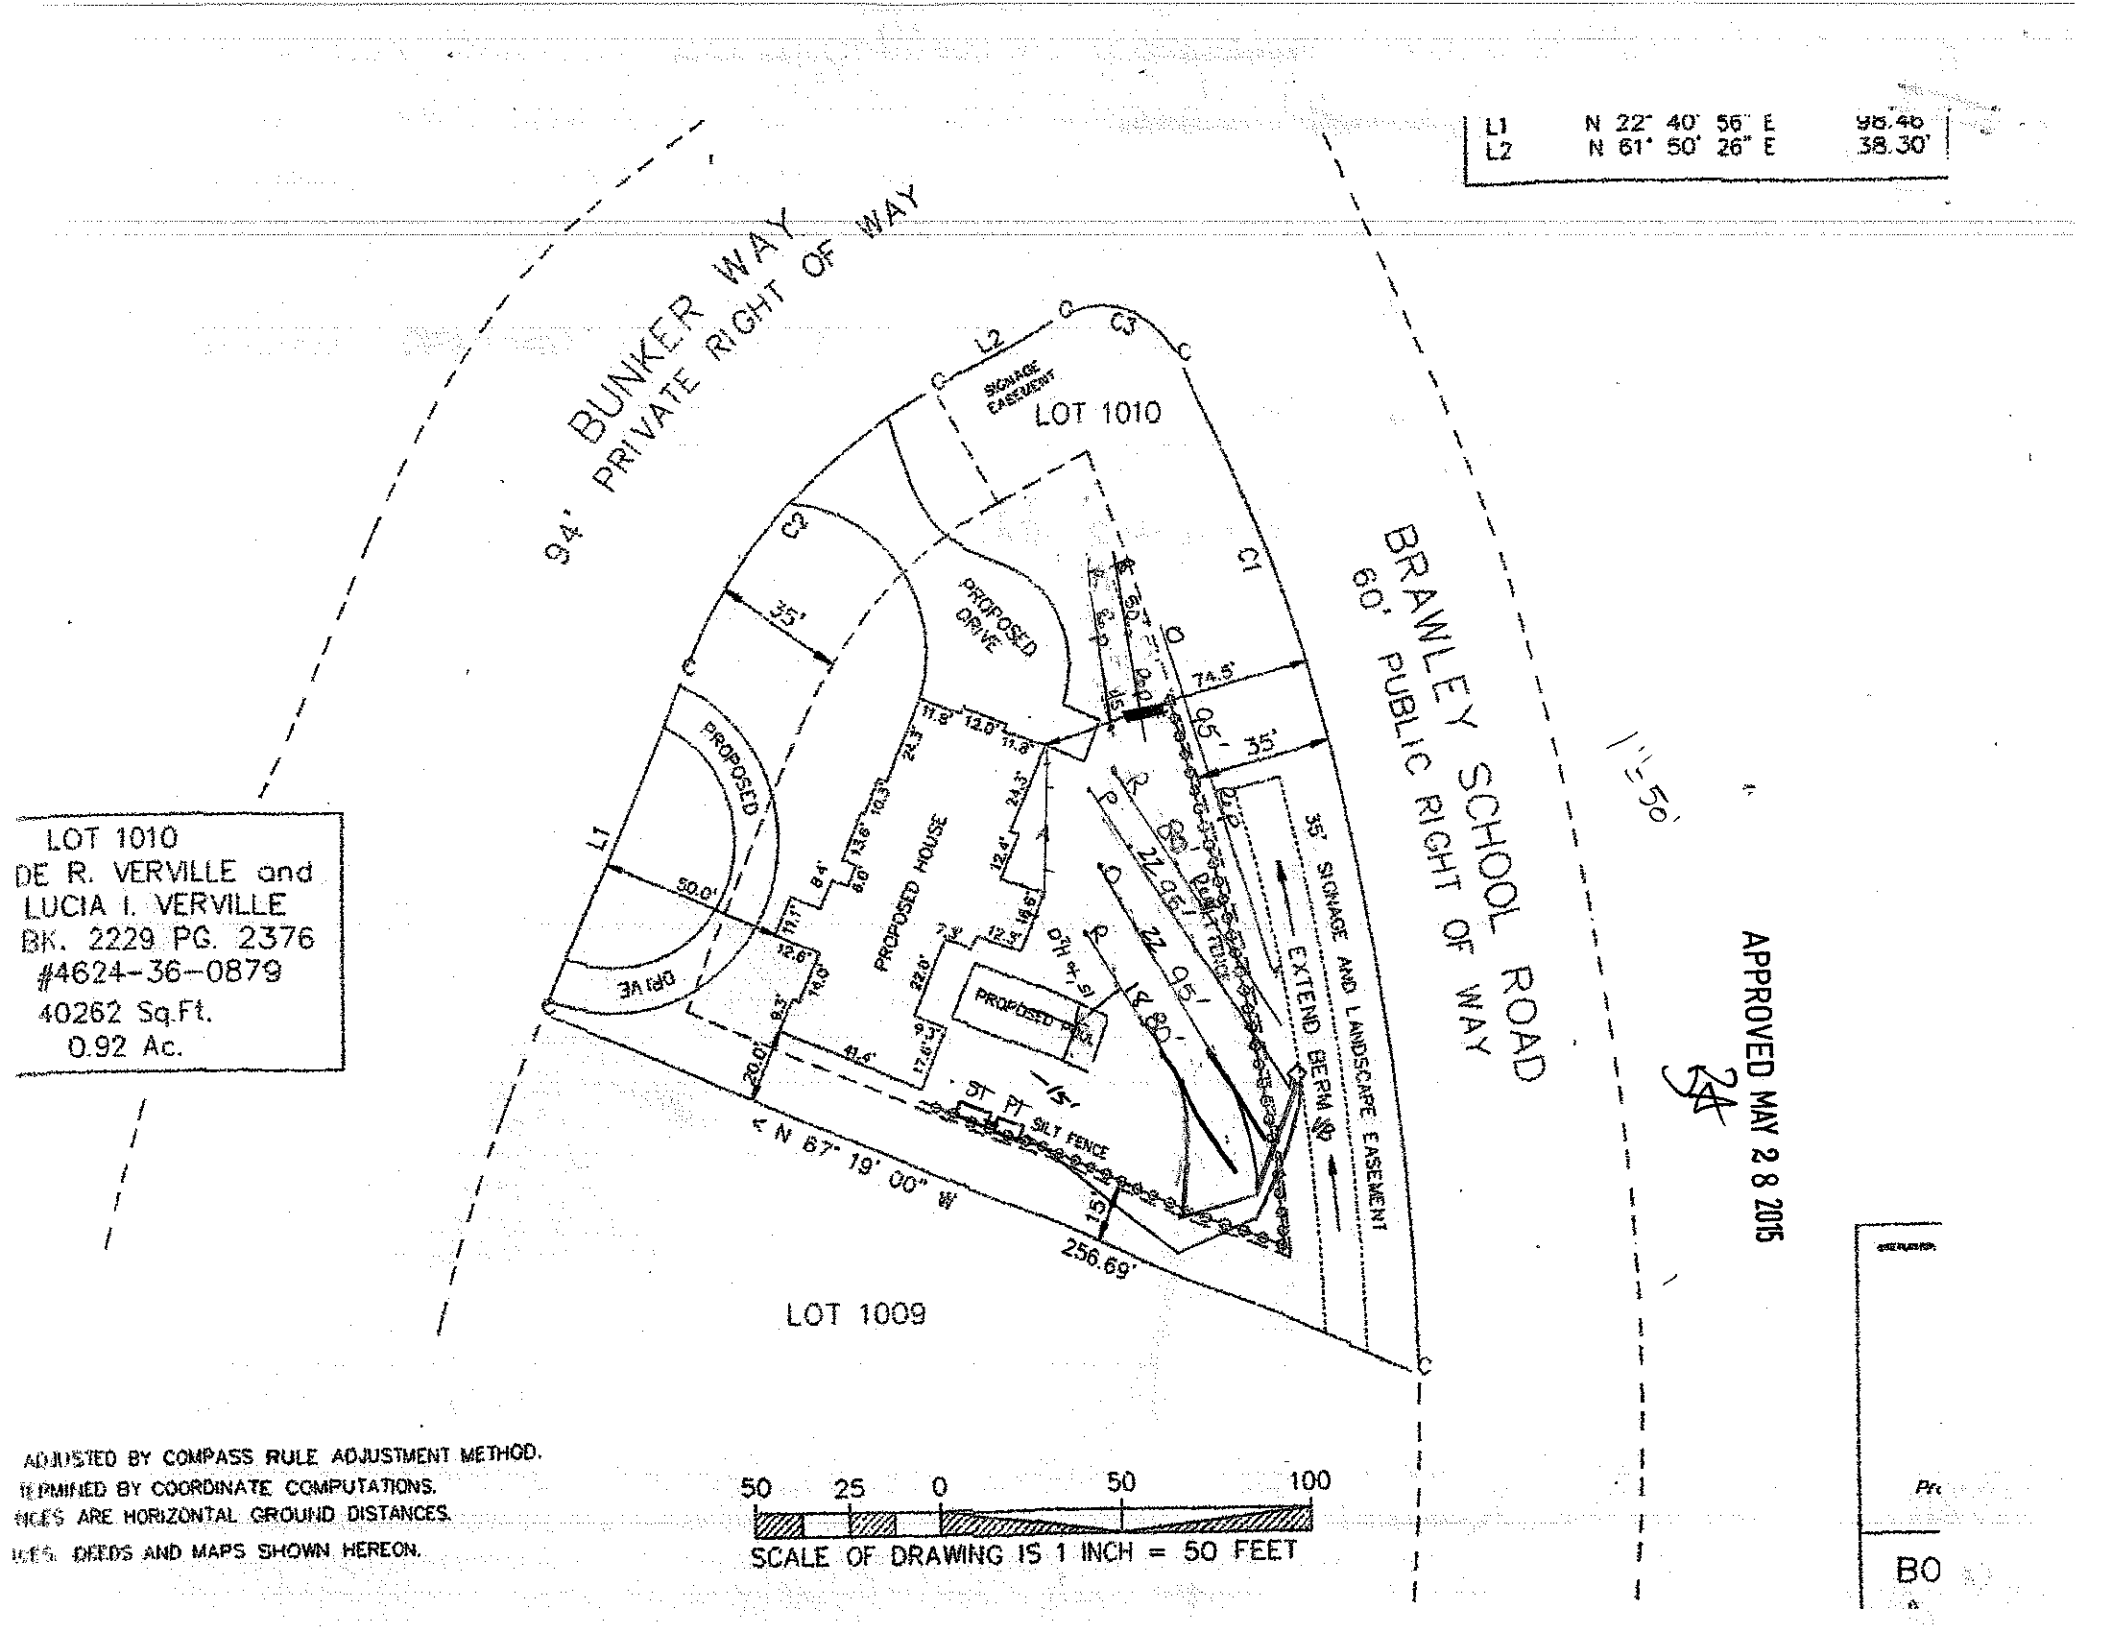
☐ **IMPROVEMENT PERMIT** *with plat valid without expiration.* ☐ **IMPROVEMENT PERMIT** *with site plan valid for 60 mos.* ☑ **AUTHORIZATION TO CONSTRUCT** *valid for period equal to IMPROVEMENT PERMIT--not to exceed 60 mo.*

Owner / Applicant Signature: Kathleen Saunders Date: 6/8/15 Installed by: GROUND BREAKERS

IMPROVEMENT PERMIT by: APPROVED MAY 28 2015 Date: OPERATION PERMIT by: Marion Dotson RS Date: 4/8/16

AUTHORIZATION TO CONSTRUCT by: APPROVED MAY 28 2015 Existing System Inspected by: Date:

Health Dept. Copy - WHITE Applicant (Final Approval) - YELLOW Applicant (Conditional Approval) - PINK


BUNKER WAY
94' PRIVATE RIGHT OF WAY
BRAWLEY SCHOOL ROAD
60' PUBLIC RIGHT OF WAY
LOT 1010
LOT 1009
SIGNAGE EASEMENT
PROPOSED DRIVE
PROPOSED HOUSE
PROPOSED POOL
35' SIGNAGE AND LANDSCAPE EASEMENT
EXTEND BERM
SILT FENCE
L1 N 22° 40' 56" E 98.46
L2 N 61° 50' 26" E 38.30
C N 67° 19' 00" W
256.69'
LOT 1010
DE R. VERVILLE and
LUCIA I. VERVILLE
BK. 2229 PG. 2376
#4624-36-0879
40262 Sq.Ft.
0.92 Ac.
ADJUSTED BY COMPASS RULE ADJUSTMENT METHOD.
TERMINED BY COORDINATE COMPUTATIONS.
NCES ARE HORIZONTAL GROUND DISTANCES.
UES, DEEDS AND MAPS SHOWN HEREON.
50 25 0 50 100
SCALE OF DRAWING IS 1 INCH = 50 FEET
1" = 50'
APPROVED MAY 2 8 2015
BO