IREDELL COUNTY HEALTH DEPARTMENT

STATESVILLE 704-878-5305 MOORESVILLE 704-664-5281

IMPROVEMENT PERMIT / AUTHORIZATION TO CONSTRUCT / OPERATION PERMIT / EXISTING SYSTEM INSPECTION

11:30

PERMIT# 25170 PIN# ~~4624362585 037~~ 4624362181

OWNER OR CONTRACTOR POINT ON NORMAN / Simonini PHONE: Business 660-1185 Home

ADDRESS 2214 BRAWLEY SCHOOL RD MOORESVILLE NC 28115 DATE 4/12/05

LOCATION BRAWLEY SCHOOL - TL HOPKINSON - TR 4 ALLEY - ON RT

SUBDIVISION POINT BLOCK / SECTION 10 LOT 1037 LOT AREA 5.1827 SITE CLASS RS DESIGN FLOW 450GPD L.T.A.R. 3650 SF

Septic Tank: ~~1000~~ 1500 Gallons: STB 338 Date 9-21-05

Pump Tank: Gallons: PT Date

Pump Make: Model Serial No.

Nitrification Field: No Fields 1 Square Feet 1200 Linear Feet 400

No Lines 4@100' Trench Width 36" Max Trench Bottom Depth 36" Gravel Depth N/A

☒ New System ☐ Repair System Type: I, II, (III), IV, V, VI

System Description: GRAVITY 3 BR RATHERWAY

Repair System Description: SAME

Maintenance Agreement Required: ☐ Yes ☒ No

☐ Slab ☐ Crawl Space ☐ Basement w/plumbing ☐ Basement wo/plumbing

☒ House/Mod. Home No. Bedrooms 4

☐ Mobile Home No. Bathrooms 4

☐ Business No. Employees


☐ Other

Water Supply: ☐ Individual ☐ Public ☒ Community


Comments/Conditions: Reviewed Building plans in Compliance with original permit. SILT POND TO BE REMOVED BEFORE O/P CAN BE ISSUED

Comments/Conditions: ~~X~~ Place house as shown

1"=50' INITIAL SITE SKETCH

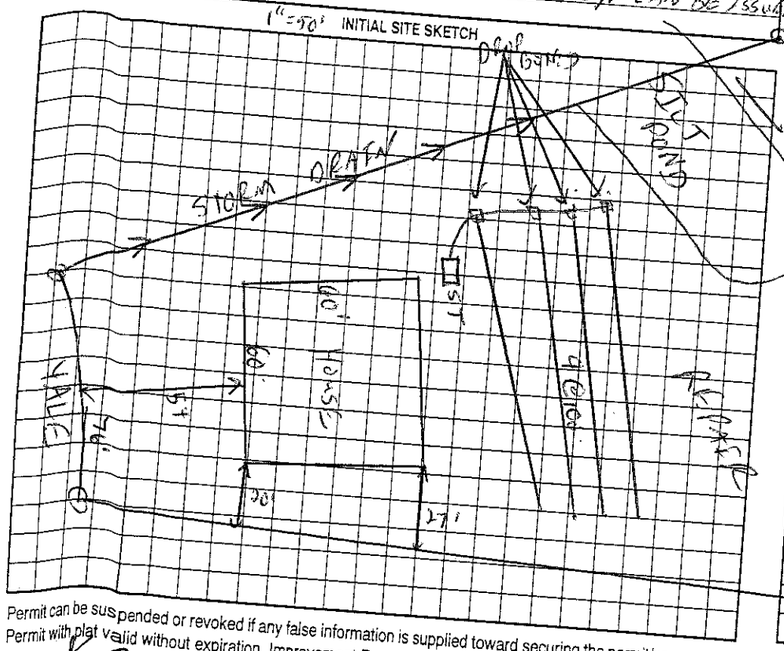

AS BUILT SKETCH

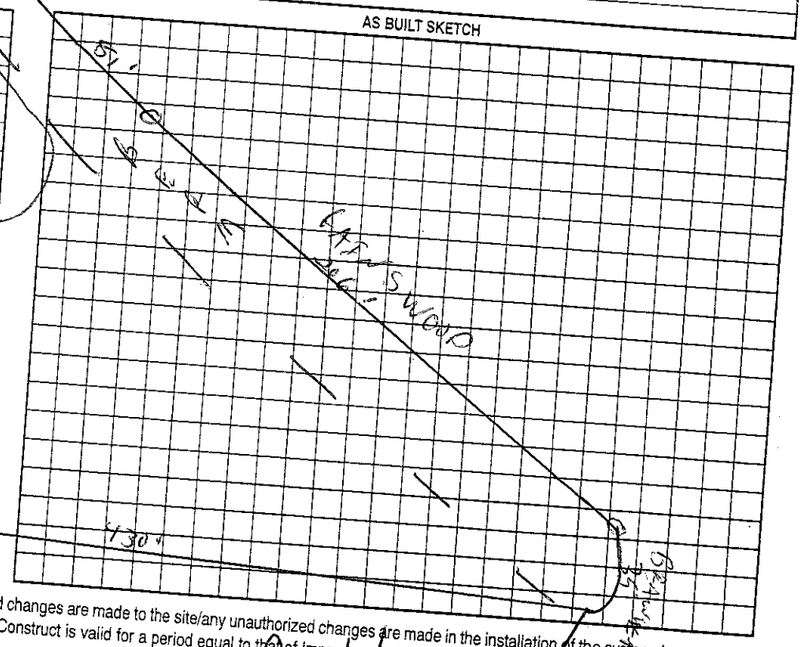

Permit can be suspended or revoked if any false information is supplied toward securing the permit/any unauthorized changes are made to the site/any unauthorized changes are made in the installation of the system. Improvement Permit with plat valid without expiration. Improvement Permit with site plan valid for sixty months. Authorization to Construct is valid for a period equal to that of Improvement Permit – not to exceed sixty months.

Signed: Kathleen Davis

Improvement Permit by: date 4/15/05 Installed by:

Authorization to Construct by: RS date 4/12/05 Operation Permit by: RS date 10/25/05

Existing System Inspection by: date 6/2/05

HEALTH DEPT. COPY: WHITE OWNER COPY (FINAL): YELLOW OWNER COPY (INITIAL): PINK