IREDELL COUNTY HEALTH DEPARTMENT

STATESVILLE 704-878-5305 MOORESVILLE 704-664-5281

1100

IMPROVEMENT PERMIT / AUTHORIZATION TO CONSTRUCT / OPERATION PERMIT / EXISTING SYSTEM INSPECTION

PERMIT# ~~125119~~ 125119 PIN# ~~4624-36-2585.036~~ 4624-36-4082 DATE 4/12/05

OWNER OR CONTRACTOR POINT ON NORMAN / SIMONINI PHONE: Business 660-1165 Home

ADDRESS 2214 BRAWLEY SCHOOL RD - MOORESVILLE NC 28115

LOCATION BRAWLEY SCHOOL - TL HOPKINTON - TR YALE - ON RT

SUBDIVISION POINT BLOCK / SECTION 10 LOT 10 36 LOT AREA 30,021 ± SITE CLASS. PS DESIGN FLOW 450GPD L.T.A.R. ~ .23 ~~.26~~ GPD/FT

Septic Tank: 1000 Gallons; STB 338 Date 10/19/05
Pump Tank: 1000 Gallons; PT 283 Date 9/16/05
Pump Make: Goulds Model WE03J2HM Serial No.
Nitrification Field: No Fields 1 Square Feet 700 Linear Feet 350
No Lines 5@70' Trench Width 24" Max Trench Bottom Depth 30" Gravel Depth N/A

☑ New System ☐ Repair System Type: I, II, III, IV, V, VI
System Description: LP PANEL
Repair System Description: LP PANEL OFFSITE
Maintenance Agreement Required: ☑ Yes ☐ No

☑ House/Mod. Home No. Bedrooms 4
☐ Mobile Home No. Bathrooms 4
☐ Business No. Employees
☐ Other


☐ Slab ☑ Crawl Space ☐ Basement w/plumbing ☐ Basement wo/plumbing

Water Supply: ☐ Individual ☐ Public ☑ ~~Community~~


Comments:/Conditions:

Comments:/Conditions: Checked tanks & lines 10/27/05 MP

INITIAL SITE SKETCH 1" = 50'

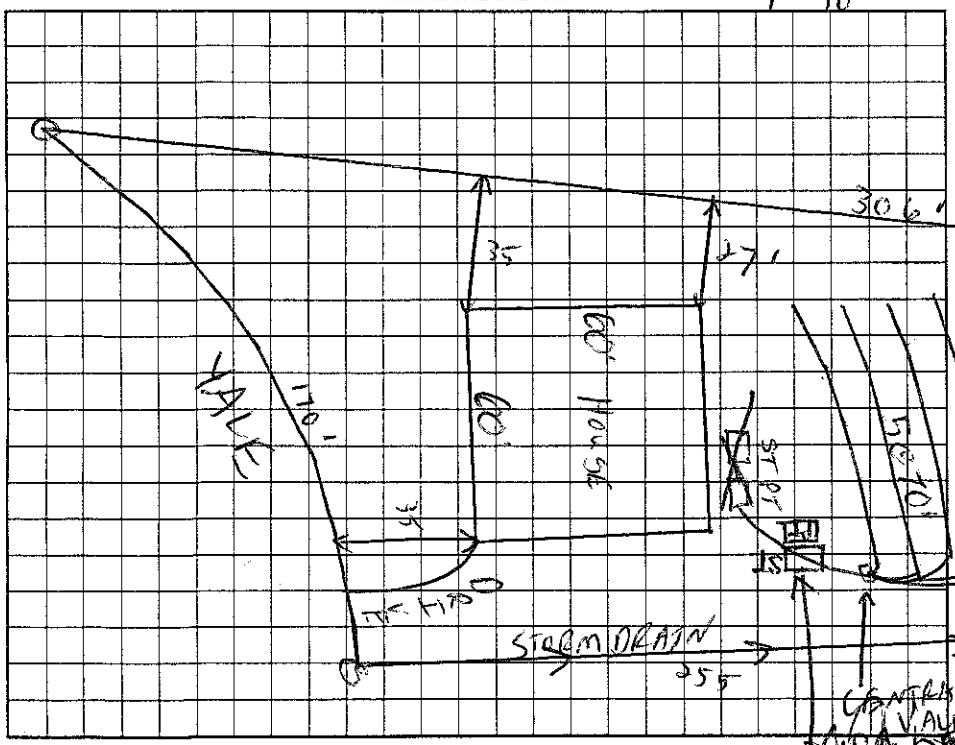

AS BUILT SKETCH

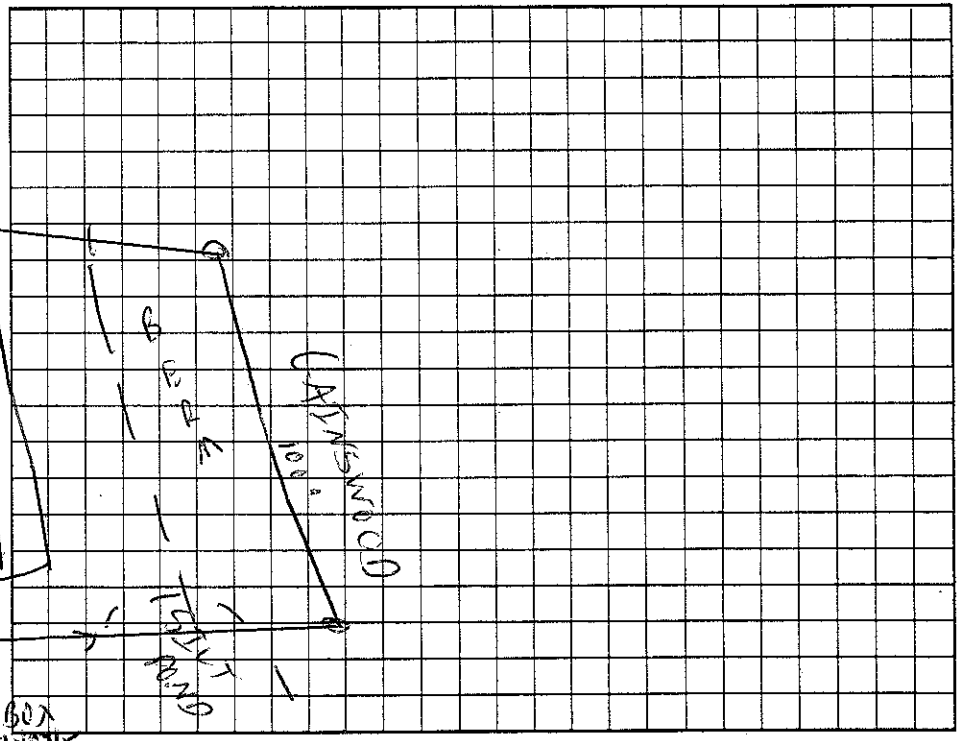

Permit can be suspended or revoked if any false information is supplied toward securing the permit, any unauthorized changes are made to the site/any unauthorized changes are made in the installation of the system. Improvement Permit with plat valid without expiration. Improvement Permit with site plan valid for sixty months. Authorization to Construct is valid for a period equal to that of Improvement Permit – not to exceed sixty months.

Signed: Kathleen Haver date 4/15/05

Improvement Permit by: C. Smith RS date 4/12/05

Authorization to Construct by: Wendy Sparks RS. date 6/1/05

Installed by: R & H

Operation Permit by: Mark H. Watson date 11/20/06

Existing System Inspection by: date

HEALTH DEPT. COPY: WHITE OWNER COPY (FINAL): YELLOW OWNER COPY (INITIAL): PINK