IREDELL COUNTY HEALTH DEPARTMENT

STATESVILLE 704-878-5305 MOORESVILLE 704-664-5281

2130

IMPROVEMENT PERMIT / AUTHORIZATION TO CONSTRUCT / OPERATION PERMIT / EXISTING SYSTEM INSPECTION

PERMIT# 25090 PIN# ~~4624-36-3555.000~~ 4624-36-4756 DATE 4/12/05

OWNER OR CONTRACTOR POINT ON NORMAN / Simonini Bldrs. PHONE: Business 660-1185 Home

ADDRESS 7214 BRAWLEY SCHOOL - MOORESVILLE NC 28115

LOCATION BRAWLEY SCHOOL - TL HOPKINTON - TL TUSCANY - ON RT

SUBDIVISION POINT BLOCK / SECTION 10 LOT 1018 LOT AREA 72,787 sf± SITE CLASS PS DESIGN FLOW 360 GPD L.T.A.R. .36 GPD/SF±

Septic Tank: 1000 Gallons; STB 338 Date 12-26-05

Pump Tank: 1000 Gallons; PT 27 Date 12-11-05

Pump Make: Goulds Model WEC3121394 Serial No.

Nitrification Field: No Fields 1 Square Feet 420 Linear Feet 210

No Lines 3@70' Trench Width 24" Max Trench Bottom Depth 36" Gravel Depth N/A

☑ New System ☐ Repair System Type: I, II, III, ☑ V, VI

System Description: LP PANEL

Repair System Description: SAME

Maintenance Agreement Required: ☑ Yes ☐ No

☑ House/Mod. Home No. Bedrooms 3

☐ Mobile Home No. Bathrooms 3

☐ Business No. Employees

☐ Other


☐ Slab ☑ Crawl Space ☐ Basement w/plumbing ☐ Basement wo/plumbing

Water Supply: ☐ Individual ☐ Public ☑ Community


Comments:/Conditions:

Comments:/Conditions: Installed as Drawn
Checked tanks & lines 2/2/06
Pressure, elect & alarm MD/ 5/2/06

INITIAL SITE SKETCH 1"=50'

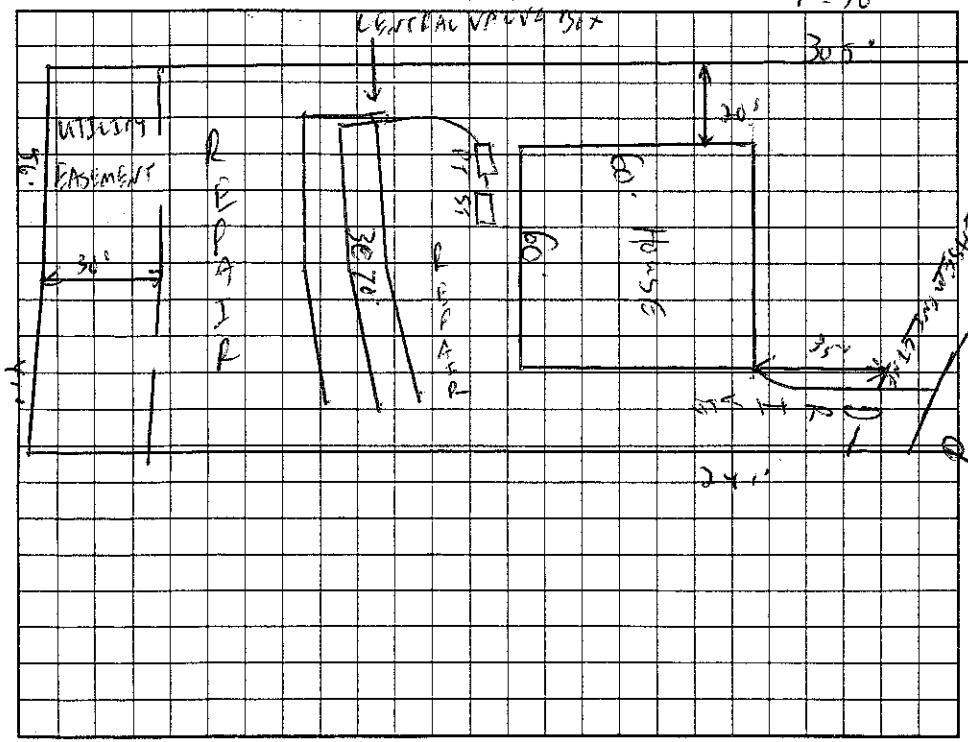

AS BUILT SKETCH

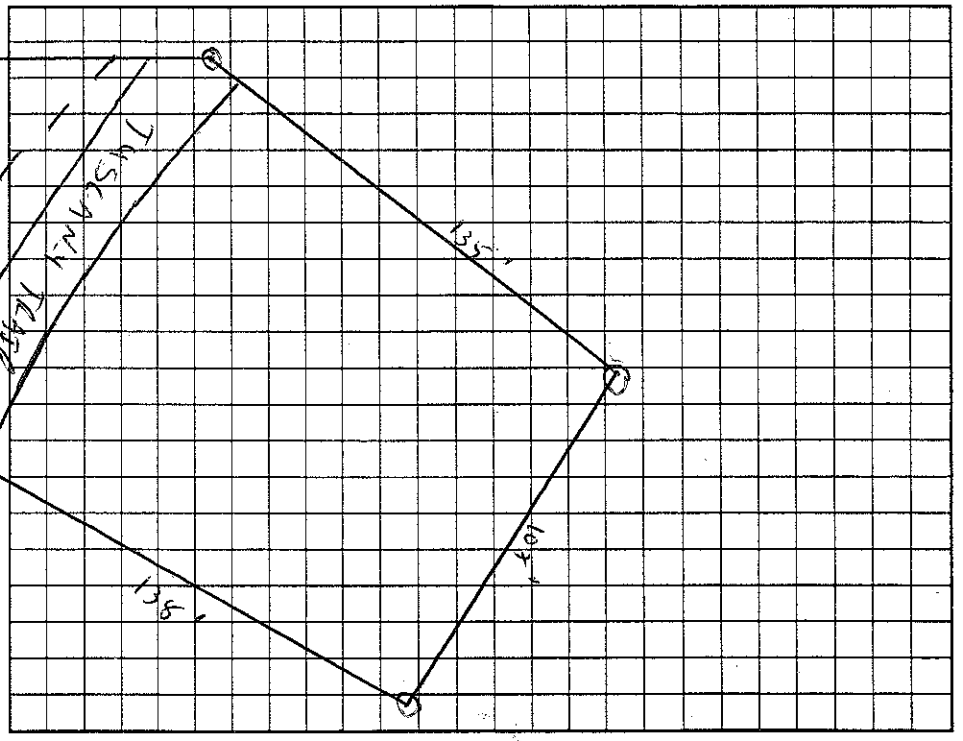

Permit can be suspended or revoked if any false information is supplied toward securing the permit/any unauthorized changes are made to the site/any unauthorized changes are made in the installation of the system. Improvement Permit with plat valid without expiration. Improvement Permit with site plan valid for sixty months. Authorization to Construct is valid for a period equal to that of Improvement Permit – not to exceed sixty months.

Signed: Kathleen Power date 4/15/05

Improvement Permit by: RS date 4/12/05

Authorization to Construct by: RS date 4/7/05

Installed by: R&H RS

Operation Permit by: Marion H. Dotson RS date 5/2/06

Existing System Inspection by: date

HEALTH DEPT. COPY: WHITE OWNER COPY (FINAL): YELLOW OWNER COPY (INITIAL): PINK