IREDELL COUNTY HEALTH DEPARTMENT

STATESVILLE 704-878-5305 — D — MOORESVILLE 704-664-5281

IMPROVEMENT PERMIT / AUTHORIZATION TO CONSTRUCT / OPERATION PERMIT / EXISTING SYSTEM INSPECTION

3:45

PERMIT# 12509 2 PIN# ~~4624 JC 2585.079~~ 4624-36-5625 DATE 4/12/05

OWNER OR CONTRACTOR POINT ON NORMAN / Simonini PHONE: Business 660-1185 Home

ADDRESS 2214 BRAWLEY SCHOOL RD - / MOORESVILLE 28115

LOCATION BRAWLEY SCHOOL - TL HOPKINSON - ON LT - CORNER OF TUSCANY TR.

SUBDIVISION POINT BLOCK / SECTION 10 LOT 1019 LOT AREA 31,461 ft² SITE CLASS PS DESIGN FLOW 360 GPD L.T.A.R. .3600/ft²

Septic Tank: 1000 Gallons; STB 338 Date 4-3-06

Pump Tank: 1000 Gallons; PT 283 Date 3-25-06

Pump Make: Gould's Model WE0.312M Serial No.

Nitrification Field: No Fields 1 Square Feet 420 Linear Feet 210

No Lines 3@70' Trench Width 24" Max Trench Bottom Depth 36" Gravel Depth N/A

☑ New System ☐ Repair System Type: I, II, III, (IV), V, VI

System Description: LP PANEL

Repair System Description: SAME

Maintenance Agreement Required: ☑ Yes ☐ No

☑ House/Mod. Home No. Bedrooms 3

☐ Mobile Home No. Bathrooms 2½

☐ Business No. Employees

☐ Other


☐ Slab ☑ Crawl Space ☐ Basement w/plumbing ☐ Basement wo/plumbing

Water Supply: ☐ Individual ☐ Public ☑ ~~Community~~

Comments/Conditions: Reviewed Building plans 7/12/05, essentially in compliance with original permit.


Comments/Conditions: ~~X~~ Must put house as shown on permit 5/23/06 Okay to move tanks to other side Checked tanks & lines 5/24/06. MD Press. elect & plan

INITIAL SITE SKETCH

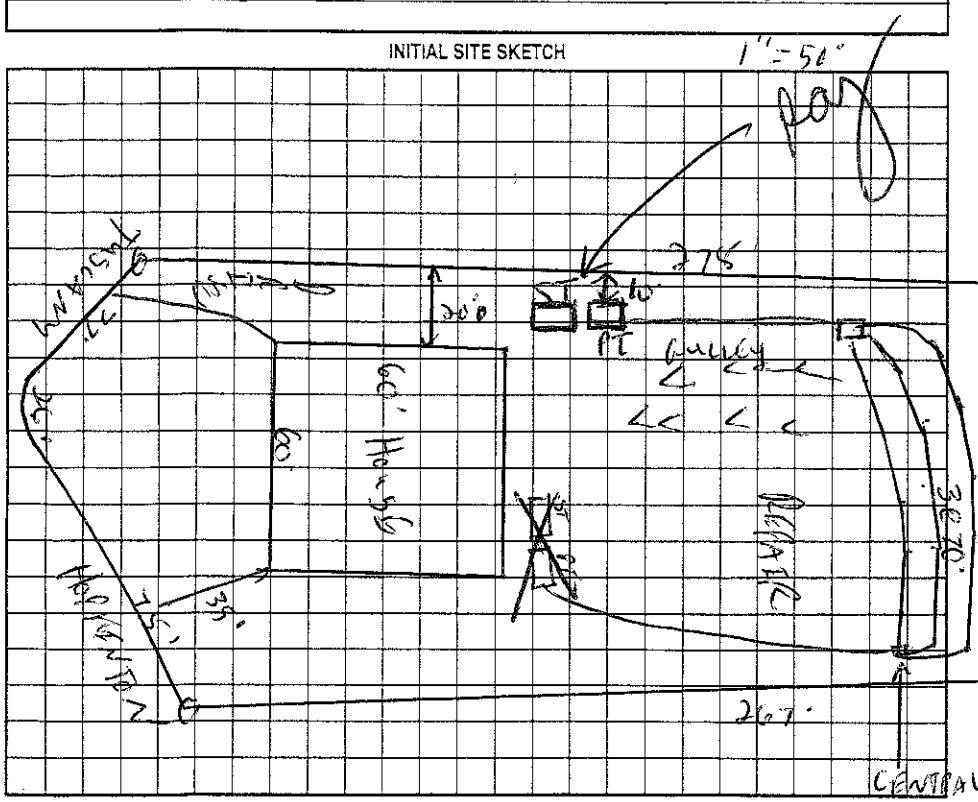

AS BUILT SKETCH 8/3/06

Installed essentially as Drawn

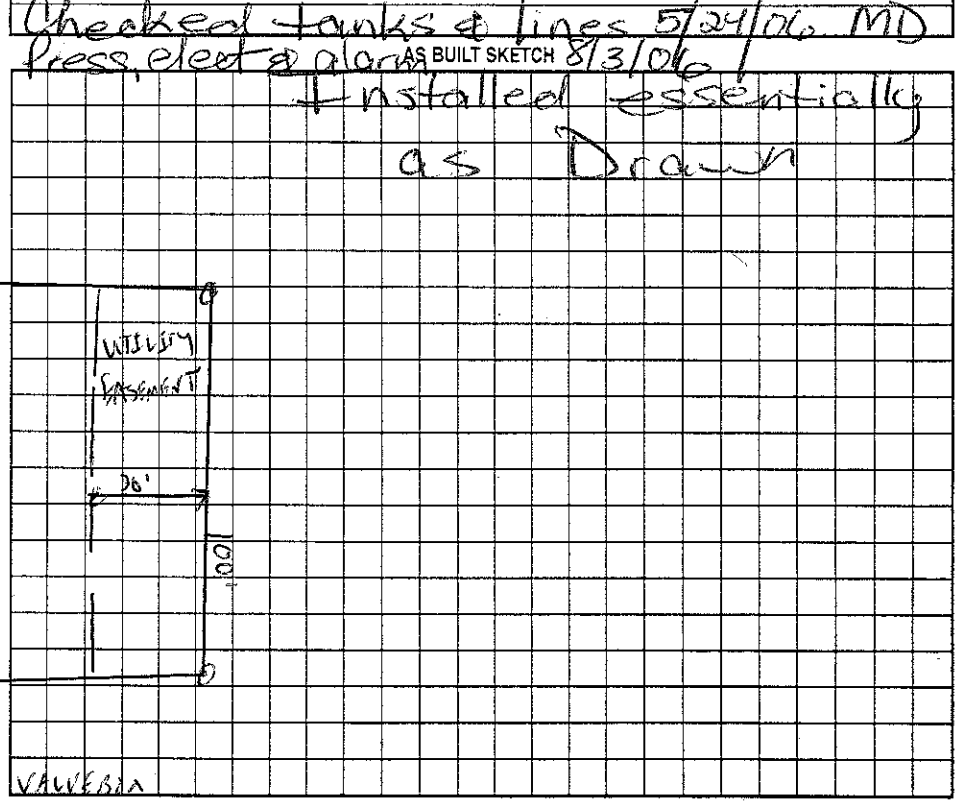

Permit can be suspended or revoked if any false information is supplied toward securing the permit/any unauthorized changes are made to the site/any unauthorized changes are made in the installation of the system. Improvement Permit with plat valid without expiration. Improvement Permit with site plan valid for sixty months. Authorization to Construct is valid for a period equal to that of Improvement Permit – not to exceed sixty months.

Signed: Kathleen Carver date 4/15/05 Installed by: R & H RS

Improvement Permit by: RS date 4/12/05 Operation Permit by: Maria H. Dotson RS date 8/3/06

Authorization to Construct by: Maria H. Dotson RS date 7/12/05 Existing System Inspection by: date

HEALTH DEPT. COPY: WHITE OWNER COPY (FINAL): YELLOW OWNER COPY (INITIAL): PINK