IREDELL COUNTY HEALTH DEPARTM

STATESVILLE 704-878-5305 MOORESVILLE 704-664-5281

IMPROVEMENT PERMIT / AUTHORIZATION TO CONSTRUCT / OPERATION PERMIT / EXISTING SYSTEM INSPECTION

PERMIT# 125096 PIN# 4624 36 2585.000 4624-36-7307 DATE 4/12/05

OWNER OR CONTRACTOR POINT ON NORMAN / Simonini PHONE: Business 660-1185 Home

ADDRESS 3214 BRAWLEY SCHOOL - MOORESVILLE NC 28115

LOCATION BRAWLEY SCHOOL - TL HOPKINTON - ON LT

SUBDIVISION POINT BLOCK / SECTION 10 LOT 1032 LOT AREA 30,107sf SITE CLASS. PS DESIGN FLOW 480GPD L.T.A.R. 3600 sf

Septic Tank: 1000 Gallons; STB 338 Date 10-18-07

Pump Tank: 1000 Gallons; PT 283 Date 6-13-07

Pump Make: Zoeller Model PN 152009 Serial No. E152-E

Nitrification Field: No Fields 1 Square Feet 540 Linear Feet 270

No Lines 3@90' Trench Width 24" Max Trench Bottom Depth 36" Gravel Depth N/A

☑ New System ☐ Repair System Type: I, II, III, (IV), V, VI

System Description: LP PANEL

Repair System Description: SAME

Maintenance Agreement Required: ☐ Yes ☐ No

☑ House/Mod. Home No. Bedrooms 4

☐ Mobile Home No. Bathrooms 4

☐ Business No. Employees

☐ Other


☐ Slab ☑ Crawl Space ☐ Basement w/plumbing ☐ Basement wo/plumbing

Water Supply: ☐ Individual ☐ Public ☐ ~~Community~~


Comments:/Conditions:

Comments:/Conditions 9/5/07 Checked tanks & lines (installed essentially as Drawn)

INITIAL SITE SKETCH 1"=50'

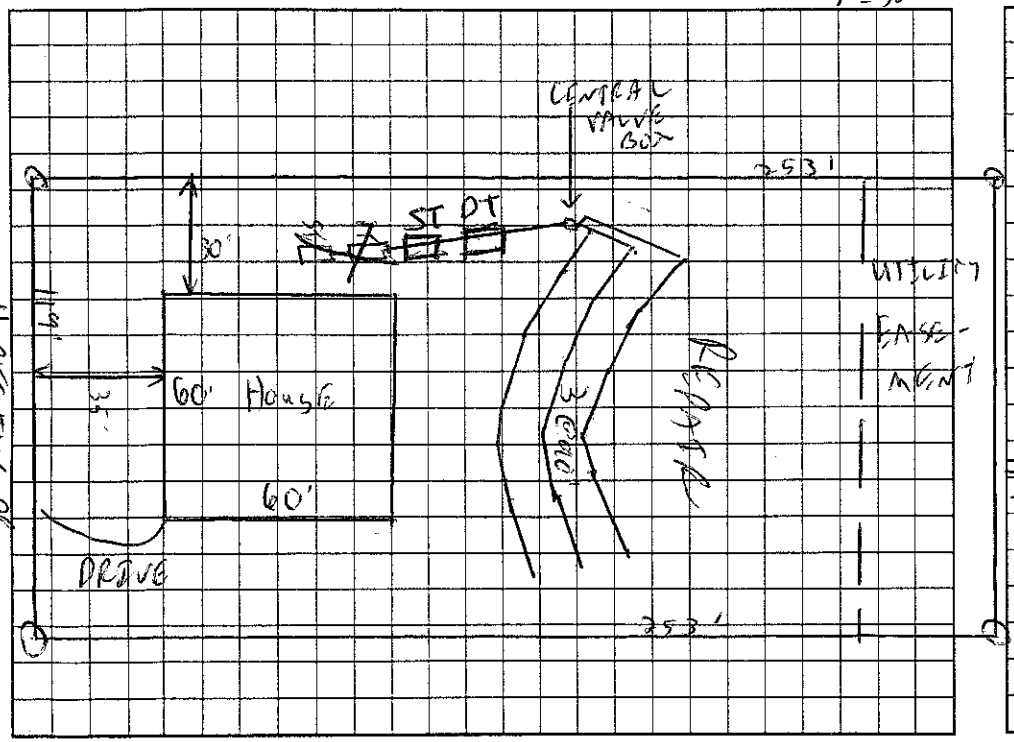

AS BUILT SKETCH

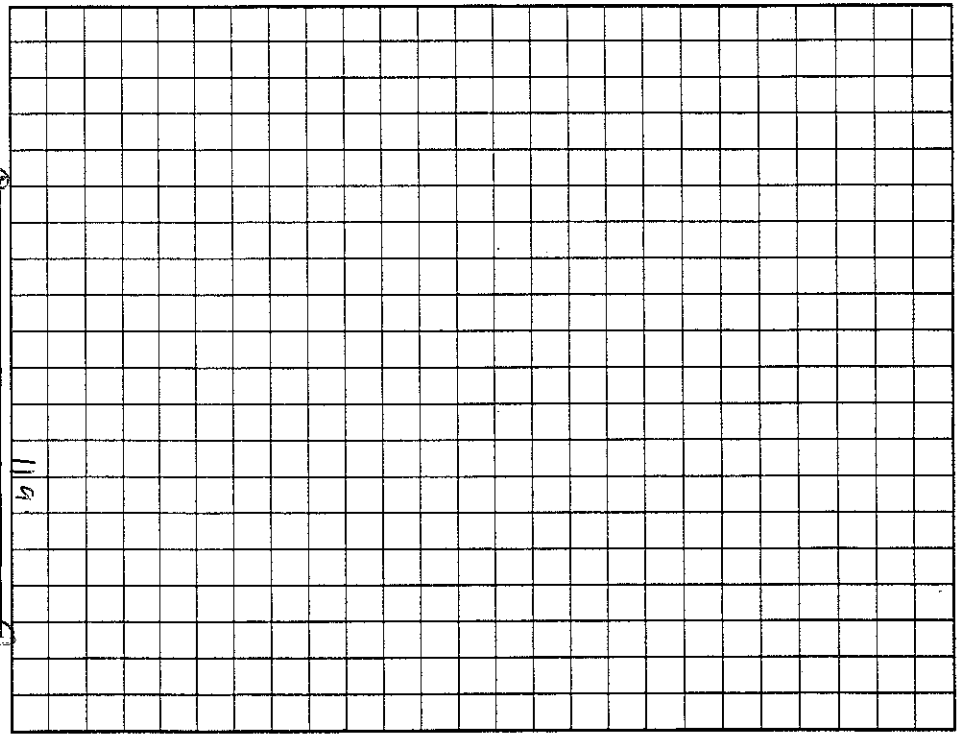

Permit can be suspended or revoked if any false information is supplied toward securing the permit/any unauthorized changes are made to the site/any unauthorized changes are made in the installation of the system. Improvement Permit with plat valid without expiration. Improvement Permit with site plan valid for sixty months. Authorization to Construct is valid for a period equal to that of Improvement Permit – not to exceed sixty months.

Signed: Kathleen Naver date 4/15/05

Improvement Permit by: [signature] date 4/12/05

Authorization to Construct by: [signature] date 4-9-07

Installed by: [signature] date

Operation Permit by: [signature] date 11/13/07

Existing System Inspection by: date

HEALTH DEPT. COPY: WHITE OWNER COPY (FINAL): YELLOW OWNER COPY (INITIAL): PINK