IREDELL COUNTY HEALTH DEPARTMENT

STATESVILLE 704-878-5305 MOORESVILLE 704-664-5281

IMPROVEMENT PERMIT / AUTHORIZATION TO CONSTRUCT / OPERATION PERMIT / EXISTING SYSTEM INSPECTION

2:00

PERMIT# 125098 PIN# ~~4624 36 1585 054~~ 4624-36-8148 DATE 4/12/05

OWNER OR CONTRACTOR POINT ON NORMAN / Simonini Bldrs PHONE: Business 660-1185 Home

ADDRESS 2214 BRAWLEY SCHOOL - MOORESVILLE NC 28115

LOCATION BRAWLEY SCHOOL - TL HOPKINTON - ON LT

SUBDIVISION POINT BLOCK / SECTION 10 LOT 1024 LOT AREA 30,109 sf SITE CLASS. PS DESIGN FLOW 450 GPD L.T.A.R. .360/.52

Septic Tank: ~~1000~~ 1500 Gallons; STB 444 Date 5/14/07

Pump Tank: 1000 Installed Gallons; PT 283 Date 5/21/07

Pump Make: Goulds Model WKC0312MU Serial No.

Nitrification Field: No Fields 1 Square Feet 0540 Linear Feet 270

No Lines 3@90' Trench Width 24" Max Trench Bottom Depth 36" Gravel Depth N/A

☑ New System ☐ Repair System Type: I, II, III, (IV), V, VI

System Description: LP PANEL

Repair System Description: SAME

Maintenance Agreement Required: ☑ Yes ☐ No

☑ House/Mod. Home No. Bedrooms 4

☐ Mobile Home No. Bathrooms 3

☐ Business No. Employees

☐ Other

☐ Slab ☑ Crawl Space ☐ Basement w/plumbing ☐ Basement wo/plumbing


Water Supply: ☐ Individual ☐ Public ☑ Community

Comments:/Conditions:

Comments:/Conditions:


7/10/07 Tanks & Drainfield checked

1" = 50' INITIAL SITE SKETCH

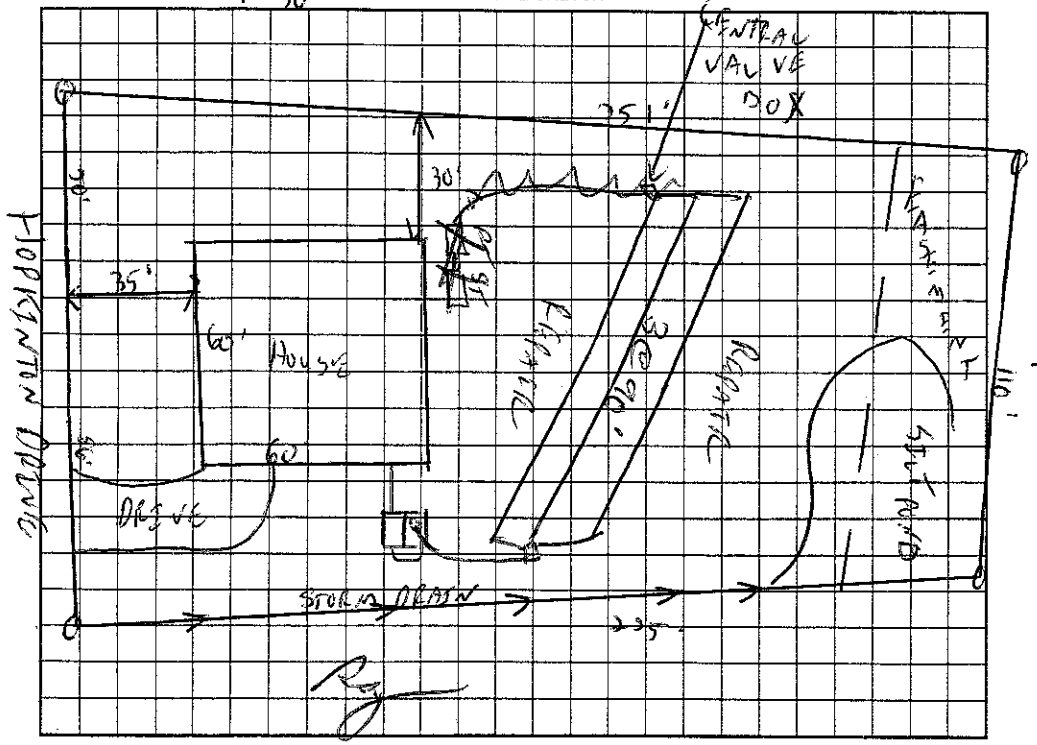

AS BUILT SKETCH

9/10/07 Pressure/Alarm/Valve box/electrical checked by L.C.

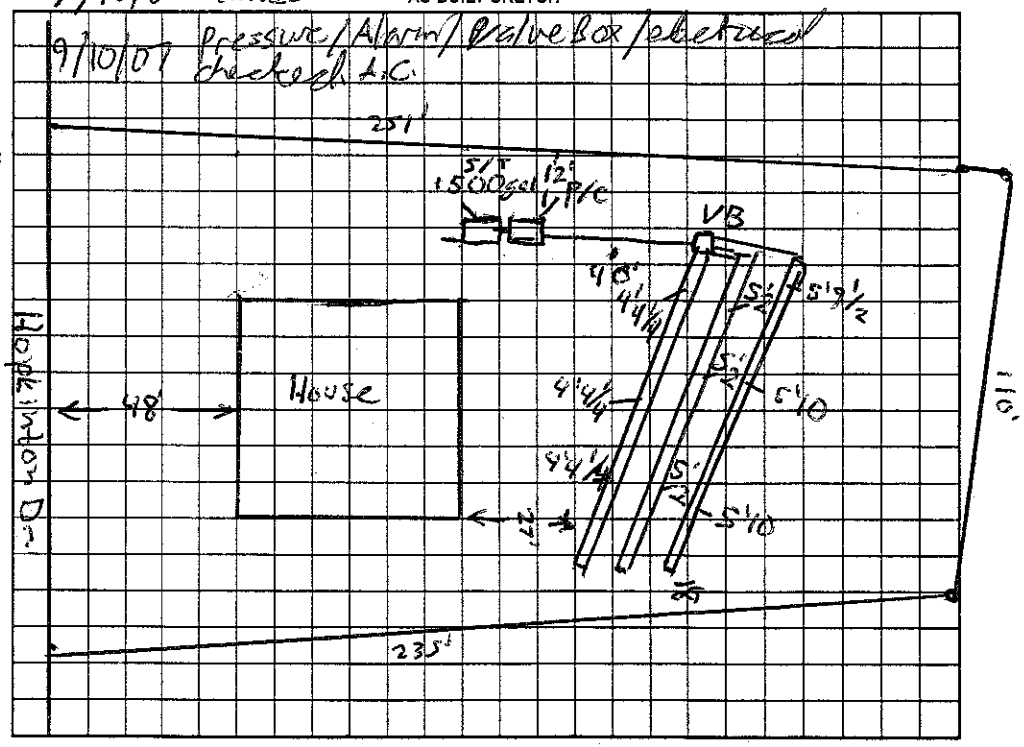

Permit can be suspended or revoked if any false information is supplied toward securing the permit/any unauthorized changes are made to the site/any unauthorized changes are made in the installation of the system. Improvement Permit with plat valid without expiration. Improvement Permit with site plan valid for sixty months. Authorization to Construct is valid for a period equal to that of Improvement Permit – not to exceed sixty months.

Signed: Kathleen Haver date 4/15/05 Installed by: ~~RNH~~ R+H

Improvement Permit by: RS date 4/12/05 Operation Permit by: Anthony Cohen Jr. date 9/10/07

Authorization to Construct by: RS date 5/16/06 Existing System Inspection by: date

HEALTH DEPT. COPY: WHITE OWNER COPY (FINAL): YELLOW OWNER COPY (INITIAL): PINK