(V)

IREDELL COUNTY HEALTH DEPARTMENT

STATESVILLE 704-878-5305 MOORESVILLE 704-664-5281

IMPROVEMENT PERMIT / AUTHORIZATION TO CONSTRUCT / OPERATION PERMIT / EXISTING SYSTEM INSPECTION

PERMIT# 129460 PIN# 4624 36 8762 DATE 10/24/06

OWNER OR APPLICANT Dr. Monte McCourt PHONE: Business 704-236-8087 Home

ADDRESS

LOCATION 161 Hainswood Dr. Mooresville, NC 28117

SUBDIVISION CLT BLOCK / SECTION 6 LOT 509 LOT AREA .706 SITE CLASS. PS DESIGN FLOW 480 L.T.A.R. .3

Septic Tank: 1000 Gallons; STB 760 Date 3/9/07
Pump Tank: 1000 Gallons; PT 31.2 Date 4/15/07
Pump Make: ZOELLER Model N-171 Serial No.
Nitrification Field: No Fields 1 Square Feet 550 Linear Feet 275
No Lines 4 Trench Width 2-3' Max Trench Bottom Depth 3'

☒ New System ☐ Repair ☐ Expansion System Type: I II III (IV) V VI
System Description: LP - 16" PBPS
Repair System Description: < 83 Recorded Lot
Maintenance Agreement Required: ☒ Yes ☐ No

☒ House/Mod. Home ☐ Mobile Home ☐ Business ☐ Other
No. Bedrooms 4 No. Persons No. Employees

Water Supply: ☒ Individual ☐ Public ☐ Community


Gravel Depth No ☐ Gravity ☒ Pressure ☐ Slab ☐ Crawl Space ☒ Basement w/plumbing ☐ Basement wo/plumbing

Comments:/Conditions: 1 - Existing Well must be properly abandoned before system installation. 2 - New well must be located in this location


Comments:/Conditions: 3/16" holes
Drainlines & tanks checked by WS 7/11/07
Pressure, float & alarm checked by WS 9/18/07

INITIAL SITE SKETCH

(1" = 50')

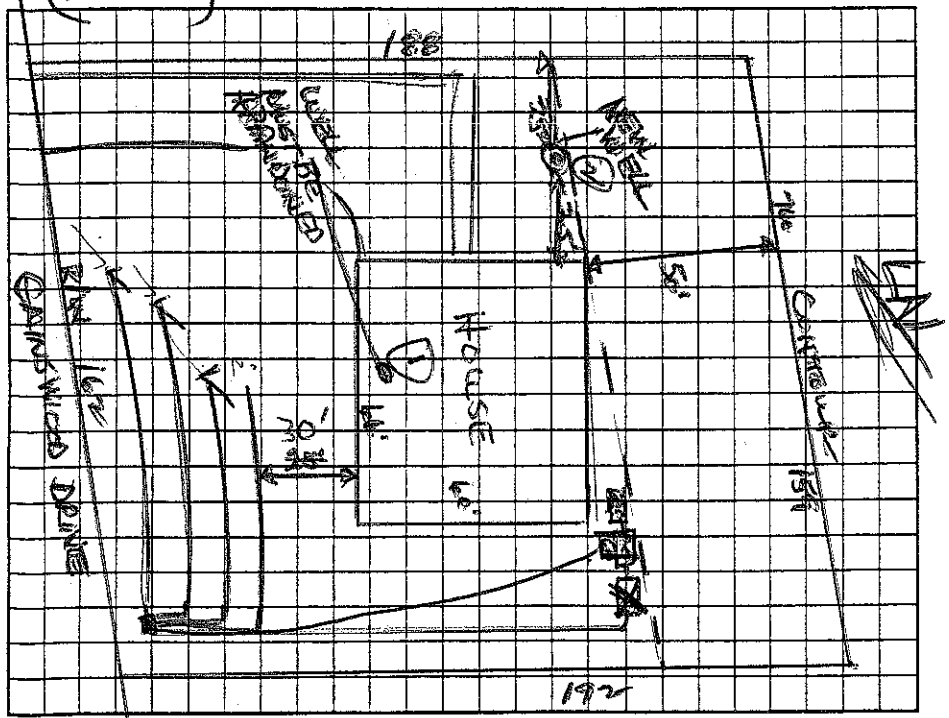

AS BUILT SKETCH

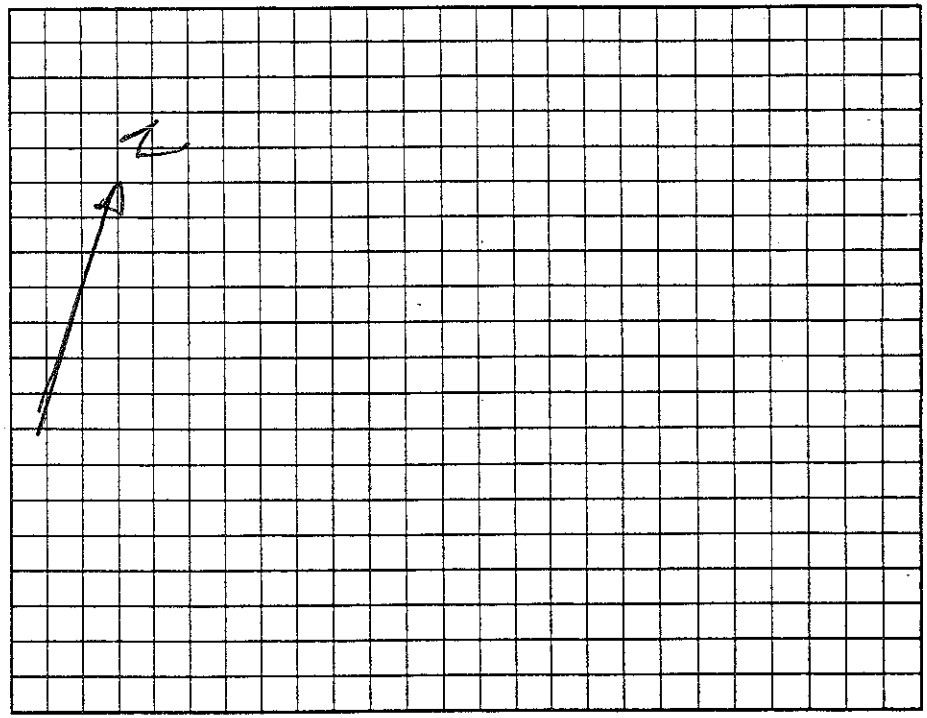

Permit can be suspended or revoked if any false information is supplied toward securing the permit/any unauthorized changes are made to the site/any unauthorized changes are made in the installation of the system. Improvement Permit with plat valid without expiration ☐ Improvement Permit with site plan valid for sixty months ☐ Authorization to Construct is valid for a period equal to that of Improvement Permit – not to exceed sixty months.

Signed: * Barry K Allen date 11-25-06 Installed by: Randy Miller

Improvement Permit by: Wesley Sparks RS. date 10/24/06 Operation Permit by: [signature] RS date 9/20/07

Authorization to Construct by: Wesley Sparks RS. date 10/24/06 Existing System Inspection by date

HEALTH DEPT. COPY: WHITE OWNER COPY (FINAL): YELLOW OWNER COPY (INITIAL): PINK