IREDELL COUNTY HEALTH DEPARTMENT

STATESVILLE 704-878-5305 MOORESVILLE 704-664-5281 3:00

IMPROVEMENT PERMIT / AUTHORIZATION TO CONSTRUCT / OPERATION PERMIT / EXISTING SYSTEM INSPECTION

PERMIT# 125094 PIN# ~~4624 36 2585.025~~ 4624-36-9150 DATE 4/12/05

OWNER OR CONTRACTOR POINT ON NORMAN / SIMONINI BLDRS. PHONE: Business 660-1185 Home

ADDRESS 2214 BRAWLEY SCHOOL MOORESVILLE NC 28115

LOCATION BRAWLEY SCHOOL - TL HOPKINTON - ON LT

SUBDIVISION POINT BLOCK / SECTION 10 LOT 1025 LOT AREA 30,129 ft² SITE CLASS. PS DESIGN FLOW 360GPD L.T.A.R. .2566 ft²/ft²

Septic Tank: 1000 Gallons; STB 338 Date 5-19-06
Pump Tank: 1000 Gallons; PT 27 Date 4-15-06
Pump Make: Goulds Model WE0312M Serial No. DD04626
Nitrification Field: No Fields 1 Square Feet 500 Linear Feet 250
No Lines 3 Trench Width 24" Max Trench Bottom Depth 36" Gravel Depth N/A

☑ New System ☐ Repair System Type: I, II, III, (IV), V, VI
System Description: CP PANEL
Repair System Description: SAME
Maintenance Agreement Required: ☑ Yes ☐ No


☑ House/Mod. Home No. Bedrooms 3
☐ Mobile Home No. Bathrooms 3
☐ Business No. Employees
☐ Other
☐ Slab ☑ Crawl Space ☐ Basement w/plumbing ☐ Basement wo/plumbing

Water Supply: ☐ Individual ☐ Public ☑ Community

Comments:/Conditions:

Comments:/Conditions: Plans Revised 2/2/06 - Essentially Complies w/ AWS.
Checked tanks 7/11/06 MD
Lines Checked 7/14/06 MD

INITIAL SITE SKETCH 1"=50'

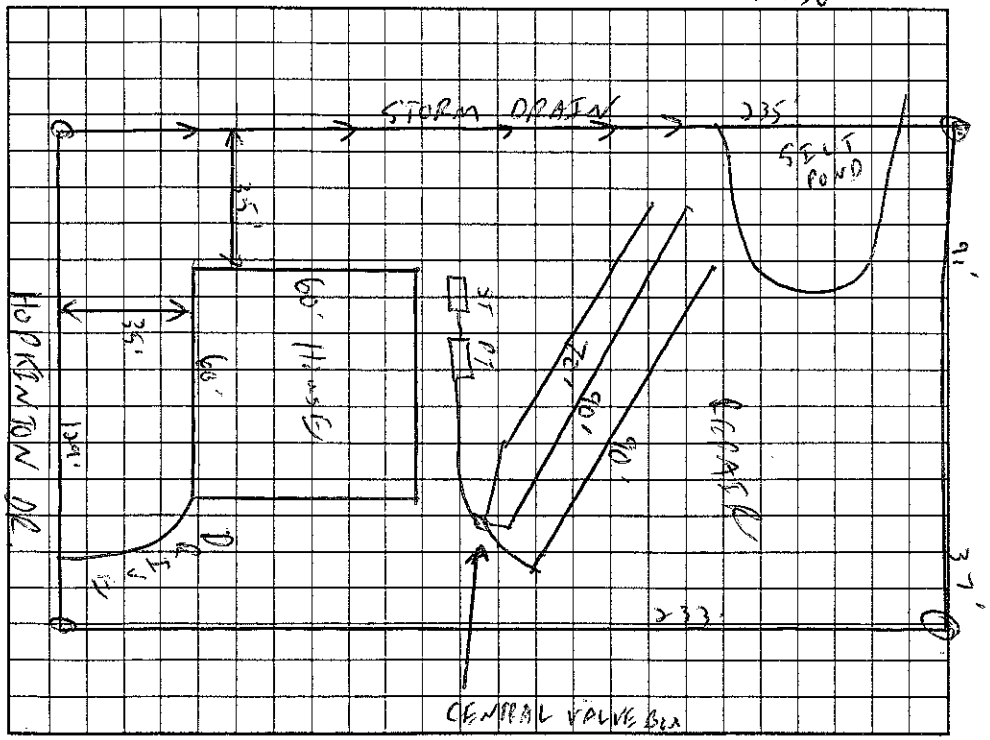

AS BUILT SKETCH

Installed as Drawn
Drilled 3/16" hole.

Permit can be suspended or revoked if any false information is supplied toward securing the permit/any unauthorized changes are made to the site/any unauthorized changes are made in the installation of the system. Improvement Permit with plat valid without expiration. Improvement Permit with site plan valid for sixty months. Authorization to Construct is valid for a period equal to that of Improvement Permit – not to exceed sixty months.

Signed: Kathleen Raver date 4/15/05
Improvement Permit by: [signature] RS date 4/12/05
Authorization to Construct by: [signature] RS date 2/2/06

Installed by: R & H date
Operation Permit by: [signature] RS date 9/7/06
Existing System Inspection by: date

HEALTH DEPT. COPY: WHITE OWNER COPY (FINAL): YELLOW OWNER COPY (INITIAL): PINK