IREDELL COUNTY HEALTH DEPARTMENT

STATESVILLE 704-878-5305 MOORESVILLE 704-664-5281

IMPROVEMENT PERMIT / AUTHORIZATION TO CONSTRUCT / OPERATION PERMIT / EXISTING SYSTEM INSPECTION

PERMIT# 106434 PIN# 4624377607 4624371697 DATE 9-12-07

OWNER OR APPLICANT Doug Johnson PHONE: Business 460-5066 Home

ADDRESS P.O. Box 1065 Huntersville, NC 28070

LOCATION Brawley School Rd TL Gainswood on left Corner

SUBDIVISION CraTy BLOCK / SECTION LOT 1740 LOT AREA 2.52Acre SITE CLASS. PS DESIGN FLOW 600gpd L.T.A.R. .25

Septic Tank: 1500 Gallons; STB 338 Date 11-13-07

Pump Tank: 1500 Gallons; PT 477 Date 9-1-07

Pump Make: Gould Model WE07J2HG Serial No.

Nitrification Field: No Fields Square Feet 800' Linear Feet 400'

No Lines 5 Trench Width 24" Max Trench Bottom Depth 36" Gravel Depth N/A

☒ New System ☐ Repair ☐ Expansion System Type: I II III IV V VI

System Description: Pump-LP Panel Blk

Repair System Description: Same

Maintenance Agreement Required: ☒ Yes ☐ No

☒ House/Mod. Home ☐ Mobile Home ☐ Business ☐ Other

No. Bedrooms 5 No. Persons No. Employees

Water Supply: ☐ Individual ☒ Public ☒ Community

☐ Gravity ☒ Pressure ☐ Slab ☐ Crawl Space ☒ Basement w/plumbing ☐ Basement wo/plumbing


Comments:/Conditions:

Scale 1:60

Approved Per Site plan Submitted by Rollans Soil & Environmental Services

Use "In line" Filter on PT

INITIAL SITE SKETCH

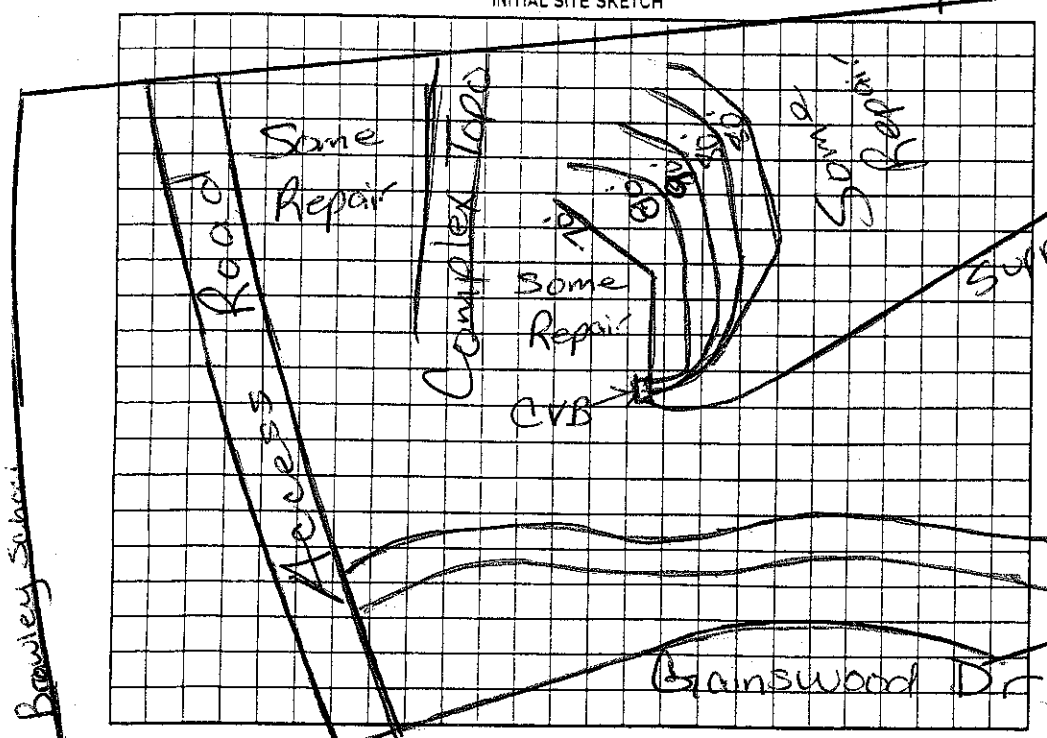

Comments/Conditions:


9/12/07 5/32" hole drilled; Checked lines

PL 40'

4/14/08 Check tanks, p

pressure

AS BUILT SKETCH

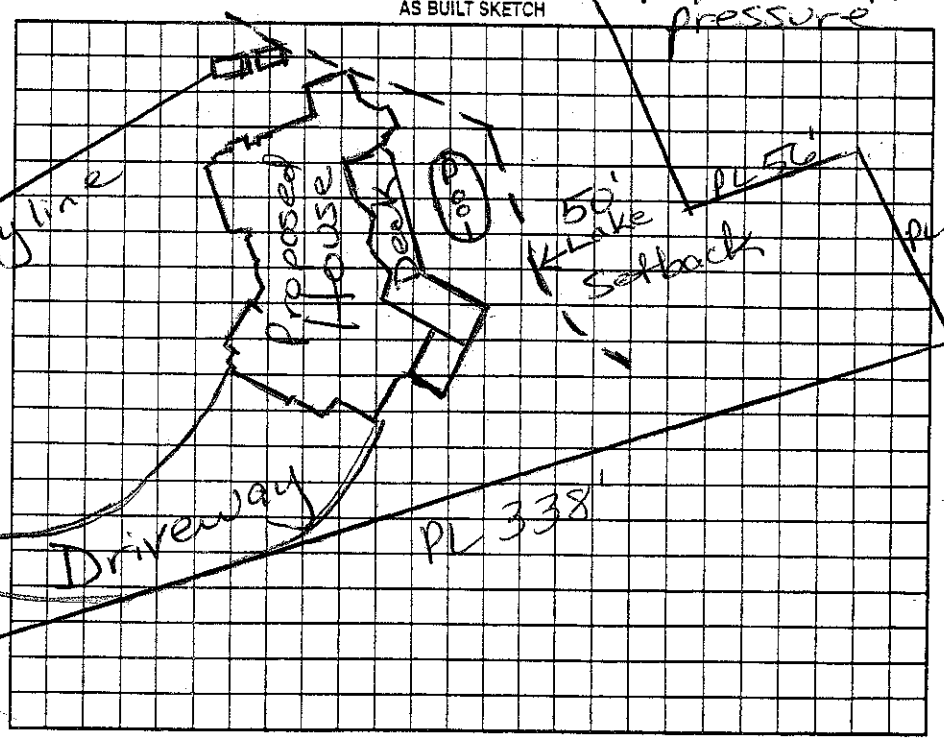

Permit can be suspended or revoked if any false information is supplied toward securing the permit/any unauthorized changes are made to the site/any unauthorized changes are made in the installation of the system. Improvement Permit with plat valid without expiration ☐ Improvement Permit with site plan valid for sixty months ☐ Authorization to Construct is valid for a period equal to that of Improvement Permit – not to exceed sixty months.

Signed: Doug Johnson date 9-13-07 Installed by: A-1 Backhoe

Improvement Permit by: Mark Hall RS date 9/12/07 Operation Permit by: Mark Hall RS date 2/20/2009

Authorization to Construct by: Mark Hall RS date 9/12/07 Existing System Inspection by: date

HEALTH DEPT. COPY: WHITE OWNER COPY (FINAL): YELLOW OWNER COPY (INITIAL): PINK