IREDELL COUNTY HEALTH DEPARTMENT

STATESVILLE 704-878-5305 MOORESVILLE 704-664-5281

IMPROVEMENT PERMIT / AUTHORIZATION TO CONSTRUCT / OPERATION PERMIT / EXISTING SYSTEM INSPECTION

PERMIT# 106435 PIN# 4624372728 4624-37-1819 DATE 1-13-06

OWNER OR APPLICANT Dienst Custom Homes PHONE: Business 892-8426 Home Jason 719-0609

ADDRESS 9606-A Caldwell Commons Circle Cornelius NC 28031

LOCATION Brawley School Rd 3rd lot on left past Greytriars

SUBDIVISION Lot BLOCK / SECTION LOT 174 LOT AREA 2.19 Acre SITE CLASS. PS DESIGN FLOW 480gpd L.T.A.R. .3

Septic Tank: 1500 Gallons; STB 338 Date 5-26-06

Pump Tank: 1500 Gallons; PT 477 Date 5-23-06

Pump Make: Myers Model MF 50 Serial No.

Nitrification Field: No Fields 1 Square Feet 1020 Linear Feet 340'

No Lines 5 Trench Width *see note Max Trench Bottom Depth 36 Gravel Depth N/A ☐ Gravity ☐ Pressure

☒ New System ☐ Repair ☐ Expansion System Type: I II III (IV) V VI

System Description: Pump-LP-Panel Block

Repair System Description: Same

Maintenance Agreement Required: ☒ Yes ☐ No

☒ House/Mod. Home ☐ Mobile Home ☐ Business ☐ Other

No. Bedrooms 5 No. Persons ___ No. Employees ___

Water Supply: ☐ Individual ☐ Public ☒ Community


☐ Slab ☐ Crawl Space ☒ Basement w/plumbing ☐ Basement wo/plumbing

Comments:/Conditions: Remove old berms.
* Trench width as specified in Crescent Communities Manual

Comments:/Conditions: Lines Check 5/22/06
Tanks Checked @ 7/7/06 MD

Scale 1:100

INITIAL SITE SKETCH

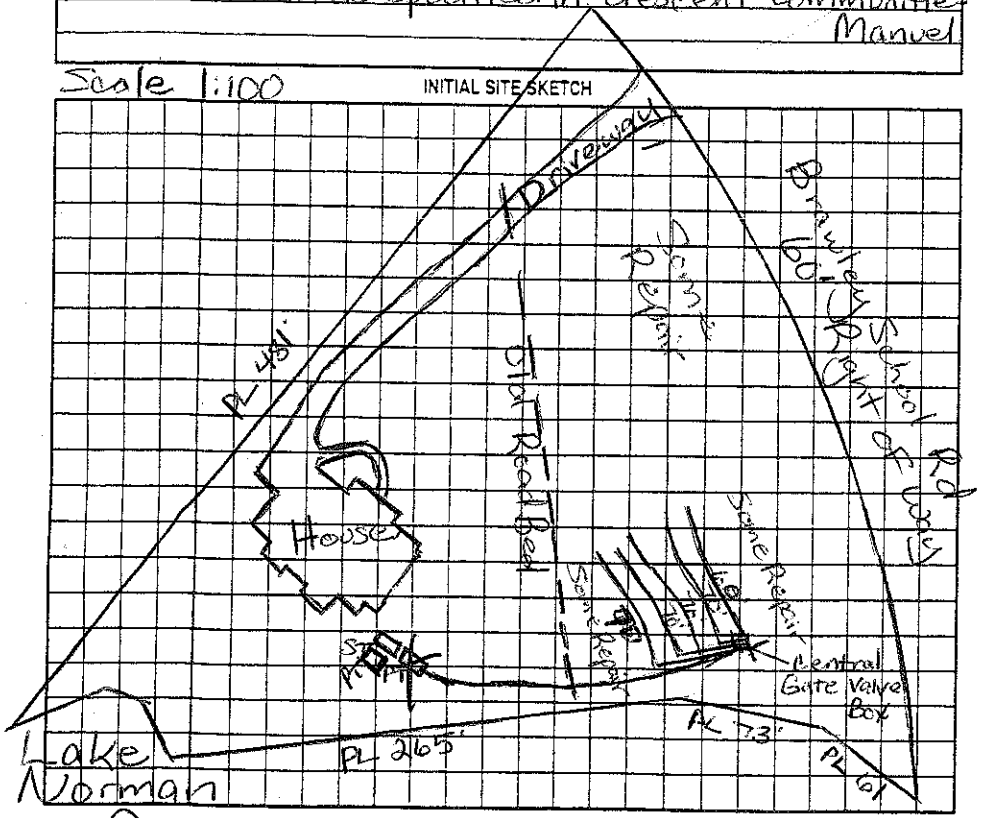

AS BUILT SKETCH

Permit can be suspended or revoked if any false information is supplied toward securing the permit/any unauthorized changes are made to the site/any unauthorized changes are made in the installation of the system. Improvement Permit with plat valid without expiration ☐ Improvement Permit with site plan valid for sixty months ☐ Authorization to Construct is valid for a period equal to that of Improvement Permit – not to exceed sixty months.

Signed: Jason Dienst date 1/17/06 Installed by: R&H Dobson RS

Improvement Permit by: Mark H Dobson RS date 1/13/06 Operation Permit by: Mark H Dobson RS date 11/4/06

Authorization to Construct by: Mark H Dobson RS date 1/13/06 Existing System Inspection by: ___ date ___

HEALTH DEPT. COPY: WHITE OWNER COPY (FINAL): YELLOW OWNER COPY (INITIAL): PINK