IREDELL COUNTY HEALTH DEPARTMENT

Statesville Office (704) 878-5305 Mooresville Office (704) 660-3625 PERMIT # 209103

IMPROVEMENT PERMIT / AUTHORIZATION TO CONSTRUCT / OPERATION PERMIT / EXISTING SYSTEM

PIN # 7624-37-1819

APPLICANT: Superior Pools / Phillip Ratcliff APPLICANT ADDRESS: 20315 Knox Rd Cornelius NC 28031

SITE ADDRESS: 7105 Gainswood Dr PHONE: 704-896-7765 ALT. PHONE: Phillip 704-662-9969

SITE DIRECTIONS: Brawley Sch Rd, TL on Gainswood, TL on first asphalt dr, last house

SUBDIVISION: The Point SECTION: 6 LOT # 174 LOT AREA: 2.187 ac DESIGN FLOW: L.T.A.R.:

Septic Tank EXISTING (gal) STB Date

Pump Tank EXISTING (gal) PT Date

Pump Make Model Serial #

Nitrification Fields 1 # Lines 5 Linear Ft: EXISTING

Trench Width EXISTING Max. Trench Bottom Depth EXISTING Gravel Depth

☐ New System ☐ Repair ☐ Expansion System Type: I II III IV V VI

System Description: EXISTING LP PPBPS

Repair System Description: LP PPBPS

Maintenance Agreement Required: ☐ YES ☐ NO

☐ GRAVITY ☐ PRESSURE

☐ Residence No. Bedrooms

☐ Business No. Persons

☑ Other No. Employees

☐ Slab ☐ Crawl Space

☐ Basement w/plumbing ☐ Basement w/o plumbing


Water Supply: ☐ Private ☐ Public ☑ Community

Comments / Conditions:

Inground Pool, Cabana/Kitchen, Bathhouse

INITIAL SITE SKETCH

AS BUILT SKETCH

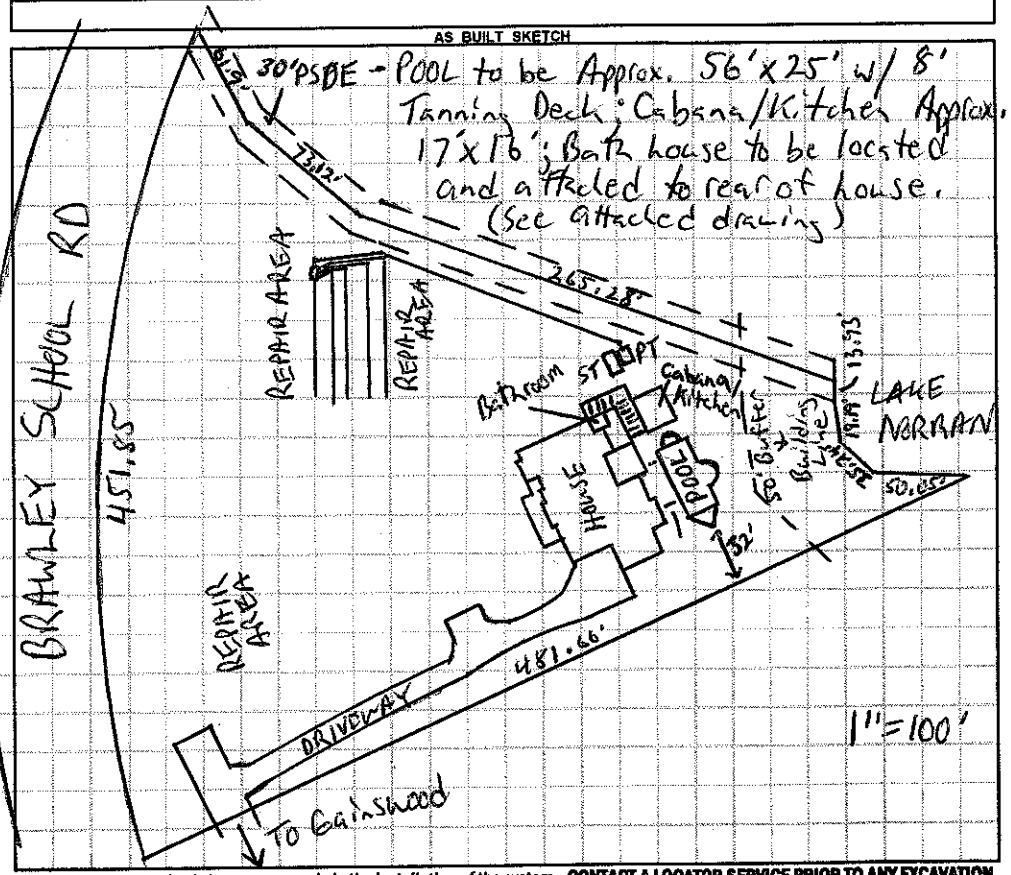

Permit can be suspended or revoked if any false information is supplied toward securing the permit / any unauthorized changes are made to the site / any unauthorized changes are made in the installation of the system. **CONTACT A LOCATOR SERVICE PRIOR TO ANY EXCAVATION**

☐ **IMPROVEMENT PERMIT** *with plat valid without expiration.* ☐ **IMPROVEMENT PERMIT** *with site plan valid for 60 mos.* ☐ **AUTHORIZATION TO CONSTRUCT** *valid for period equal to IMPROVEMENT PERMIT--not to exceed 60 mo.*

Owner / Applicant Signature: Date: 4-22-15 Installed by:

IMPROVEMENT PERMIT by: Date: OPERATION PERMIT by: Date:

AUTHORIZATION TO CONSTRUCT by: Date: Existing System Inspected by: Date: 4-9-15

Health Dept. Copy - WHITE Applicant (Final Approval) - YELLOW Applicant (Conditional Approval) - PINK