IREDELL COUNTY HEALTH DEPARTMENT

IMPROVEMENT PERMIT / AUTHORIZATION TO CONSTRUCT / OPERATION PERMIT / EXISTING SYSTEM INSPECTION

STATESVILLE 704-878-5305 MOORESVILLE 704-664-5281

PERMIT# 12506 17553 ~~4653~~ ~~4624-36-2555-044~~ 4624372191 DATE 4/13/05

OWNER OR CONTRACTOR POINT ON NORMAN/ES Johnson PHONE: Business 660-1185 Home

ADDRESS 2214 BRAWLEY SCHOOL - MOORESVILLE NC 28115 LOCATION BRAWLEY SCHOOL - TL HOPKINTON - TL TUSCANY TR - ON PT

SUBDIVISION POINT BLOCK / SECTION 10 LOT 1014 LOT AREA 30,157 ft² SITE CLASS PS DESIGN FLOW 360 L.T.A.R. 360/FT

Septic Tank: ~~1000~~ 1500 Gallons; STB 744 Date 4-10-13

Pump Tank: ~~1000~~ 1500 Gallons; PT 477 Date 3-19-13

Pump Make: Orenco Model _____ Serial No. _____

Nitrification Field: No Fields 1 Square Feet 420 Linear Feet 210

No Lines 3 @ 70' Trench Width 24" Max Trench Bottom Depth 36" Gravel Depth NA

☑ New System ☐ Repair System Type: I, II, III, IV, V, VI

System Description: LP PANEL

Repair System Description: SAME

Maintenance Agreement Required: ☑ Yes ☐ No

☑ House/Mod. Home No. Bedrooms 3

☐ Mobile Home No. Bathrooms 3

☐ Business No. Employees ____

☐ Other ____

☐ Slab ☑ Crawl Space ☐ Basement w/plumbing ☐ Basement wo/plumbing

Water Supply: ☐ Individual ☐ Public ☑ Community

Comments:/Conditions: DO NOT CUT HOUSE PAD

* Check specs for Crescent Communities On Site Wastewater Systems


Note: "Bonus Room" must be Unfinished

Comments:/Conditions:

11/6/2012 Reviewed Floor plans & Site Plan, in Compliance with original Plan.


INITIAL SITE SKETCH 1" = 50'

2" Supply line to GVB & then 1 1/4" to lines

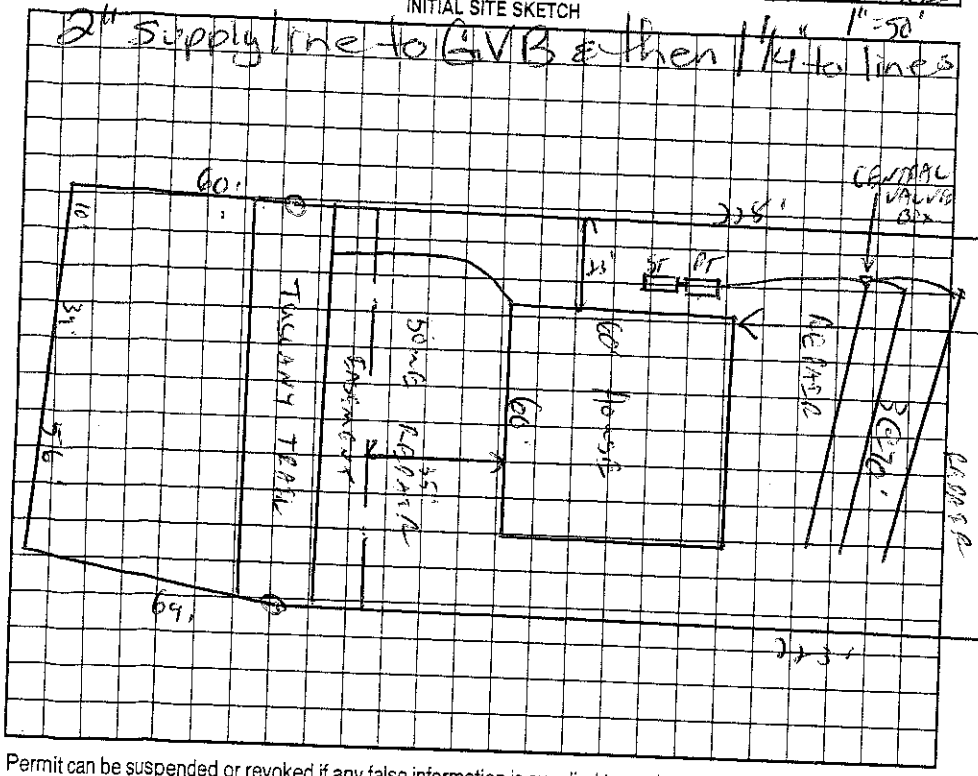

AS BUILT SKETCH

Drilled 3/16" hole Checked tanks & lines 5/21/13 Installed essentially as Drawn 7/1/13 Set pressure

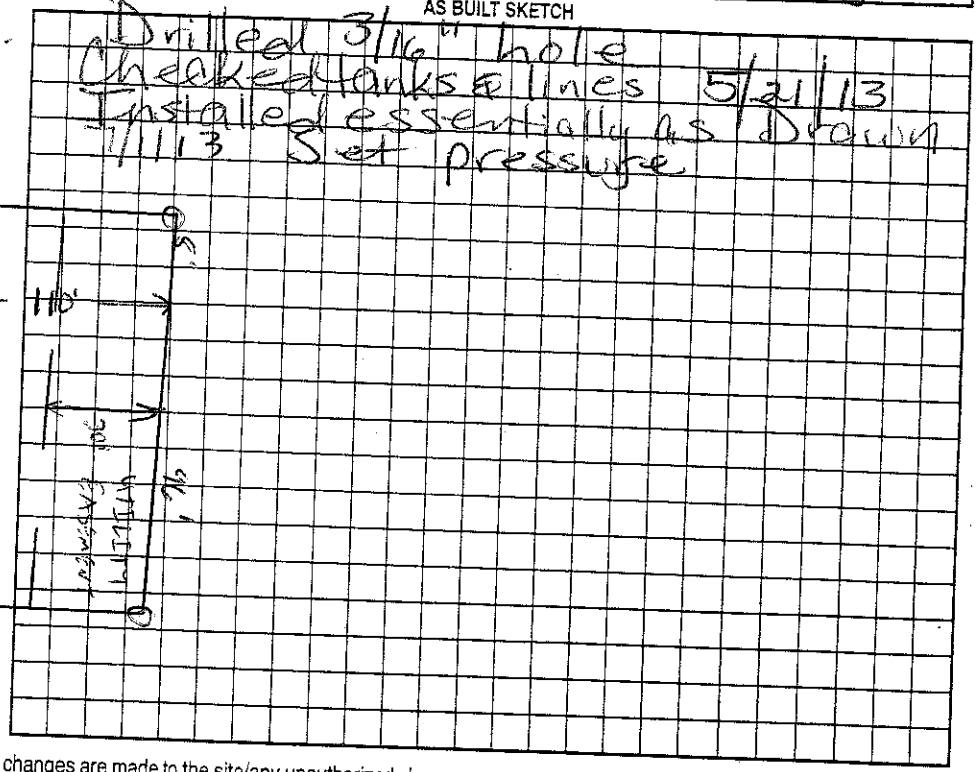

Permit can be suspended or revoked if any false information is supplied toward securing the permit/any unauthorized changes are made to the site/any unauthorized changes are made in the installation of the system. Improvement Permit with plat valid without expiration. Improvement Permit with site plan valid for sixty months. Authorization to Construct is valid for a period equal to that of Improvement Permit – not to exceed sixty months.

Signed: Kathleen Raven date 4/15/05

Improvement Permit by: [signature] RS date 4/13/05

Authorization to Construct by: [signature] RS date 11/6/12

Installed by: Willie Christenbury

Operation Permit by: [signature] RS date 7/1/13

Existing System Inspection by: _____ date _____

HEALTH DEPT. COPY: WHITE OWNER COPY (FINAL): YELLOW OWNER COPY (INITIAL): PINK