1.30

IREDELL COUNTY HEALTH DEPARTMENT

STATESVILLE 704-878-5305 MOORESVILLE 704-664-5281

IMPROVEMENT PERMIT / AUTHORIZATION TO CONSTRUCT / OPERATION PERMIT / EXISTING SYSTEM INSPECTION

PERMIT# 075892 PIN# 4624 37 5298 DATE 9/10/98

OWNER OR CONTRACTOR AMY PESTER PHONE: Business _____ Home _____

ADDRESS 621 NOKOMIS CT WINSTON SALEM NC 27106

LOCATION BRAWLEY SCHOOL - TL GAINSWOOD - OL LT - (NECK NECK) (Just past Greyfriars) 129 Gainswood

SUBDIVISION NECK NECK BLOCK / SECTION 6 LOT 513 LOT AREA .82 AC SITE CLASS. AS DESIGN FLOW 360 L.T.A.R. .30 PO/FD

Septic Tank: 1000 Gallons; STB 312 Date 8/3/99

Pump Tank: 1000 Gallons; PT 27 Date 9/14/99

Pump Make: Goulds Model WE0811H Serial No K99103187

Nitrification Field: No Fields 1 Square Feet 400 Linear Feet 200

No Lines 4@50' Trench Width 24" Max Trench Bottom Depth 36" Gravel Depth N/A

☐ New System ☐ Repair System Type: I, II, III, IV, V, VI

System Description: PUMP PANEL

Repair System Description: SAME

Maintenance Agreement Required: ☐ Yes ☒ No

☒ House/Mod. Home No. Bedrooms 3

☐ Mobile Home No. Bathrooms 2

☐ Business No. Employees ____

☐ Other ____

☐ Slab ☒ Crawl Space ☐ Basement w/plumbing ☐ Basement wo/plumbing


Water Supply: ☐ Individual ☐ Public ☐ Community

1/31/99


Comments:/Conditions: 36"

Comments:/Conditions: Health Dept wants 36" trenches.
Tanks, lines & pressure checked 10/28/99

INITIAL SITE SKETCH

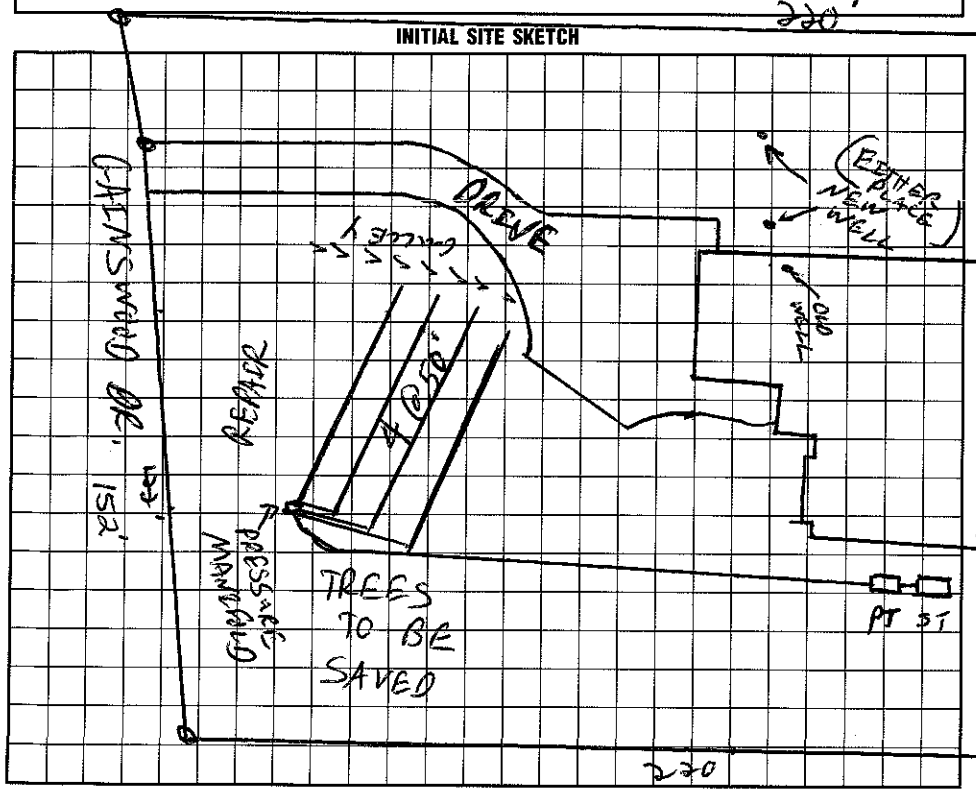

AS BUILT SKETCH

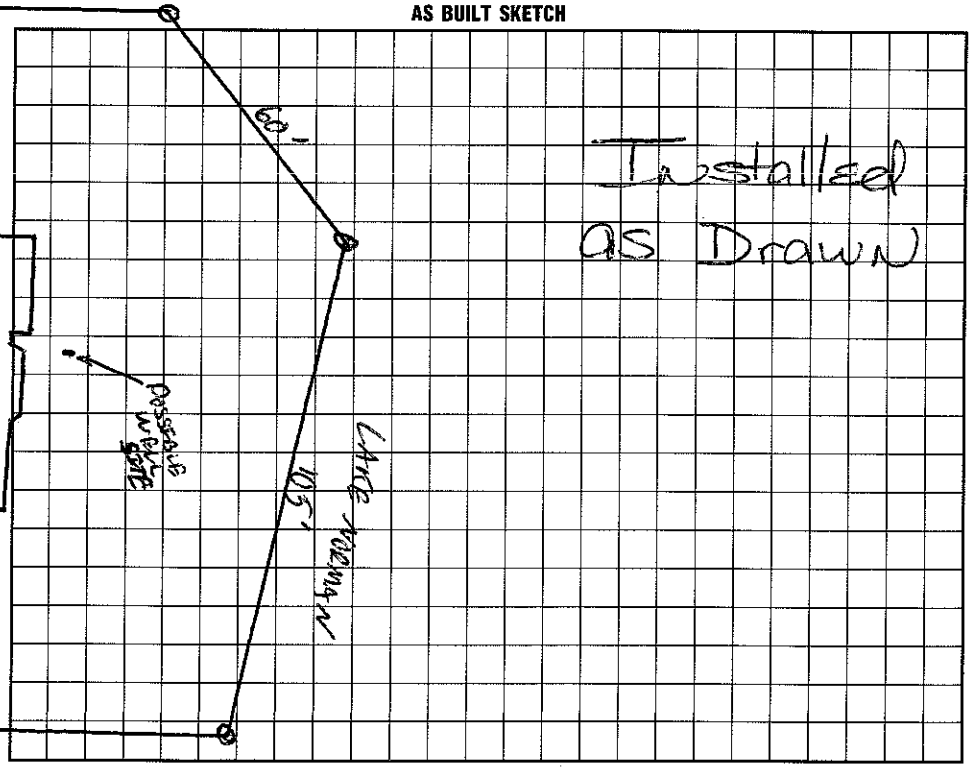

I understand that this permit can be suspended or revoked if any false information is supplied toward securing the permit/any unauthorized changes are made to the site/any unauthorized changes are made in the installation of the system. Improvement Permit with plat valid without expiration. Improvement Permit with site plan valid for sixty months. Authorization to Construct is valid for a period equal to that of Improvement Permit – not to exceed sixty months.

Signed: [signature] date 9/15/98 Installed by: E.J. Ervin

Improvement Permit by: [signature] date 9/10/98 Operation Permit by: _____ date _____

Authorization to Construct by: [signature] date 9/10/98 Existing System Inspection by: [signature] date 11/8/99

HEALTH DEPT. COPY: WHITE INSPECTION COPY (FINAL): GREEN OWNER COPY (FINAL): YELLOW INSPECTION COPY (INITIAL): PINK OWNER COPY (INITIAL): GOLD