IREDELL COUNTY HEALTH DEPARTMENT

Statesville Office (704) 878-5305 Mooresville Office (704) 660-3625 PERMIT # 202270

IMPROVEMENT PERMIT / AUTHORIZATION TO CONSTRUCT / OPERATION PERMIT / EXISTING SYSTEM

PIN # 4624376154

APPLICANT: Sherry Garner APPLICANT ADDRESS: 139 Gainswood Mooresville, NC

SITE ADDRESS: 139 Gainswood PHONE: 704 906-9516 ALT. PHONE:

SITE DIRECTIONS: Brawley School Rd TL Gainswood on left ~1/2 way down

SUBDIVISION: CLST SECTION: 6 LOT # 512 LOT AREA: DESIGN FLOW: 360gpd T.A.R.:

Septic Tank Exist. 1000 (gal) STB Date
Pump Tank (gal) PT Date
Pump Make Model Serial #
Nitrification Fields 2 # Lines 3 Linear Ft: 300
Trench Width 7½' Bed Max. Trench Bottom Depth Gravel Depth 17"


☐ New System ☐ Repair ☐ Expansion System Type: I II III IV V VI
System Description: Expl. Grav. Conventional
Repair System Description:
Maintenance Agreement Required: ☐ YES ☐ NO
☒ GRAVITY ☐ PRESSURE

☒ Residence No. Bedrooms 3
☐ Business No. Persons 6
☐ Other No. Employees
☐ Slab ☐ Crawl Space
☐ Basement w/plumbing ☐ Basement w/o plumbing


Water Supply: ☒ Private ☐ Public ☐ Community

Comments / Conditions: Existing Septic & repair permitted by Meklenburg County for 3 Bedrooms.

INITIAL SITE SKETCH

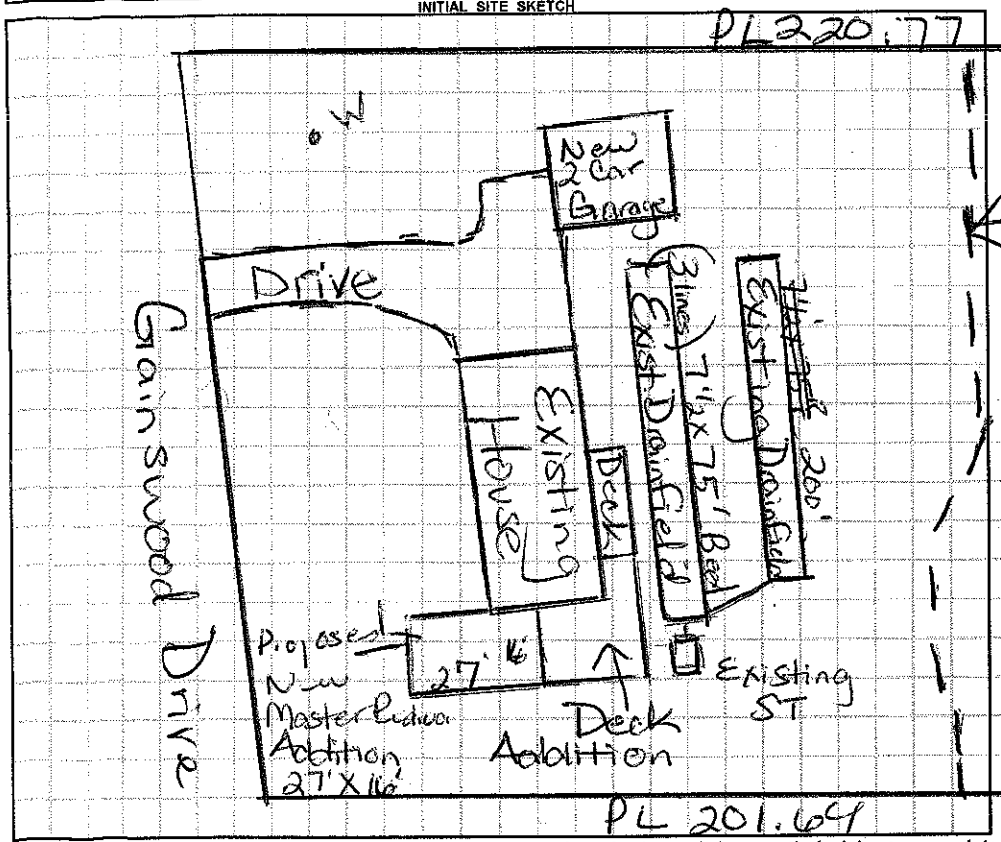

AS BUILT SKETCH

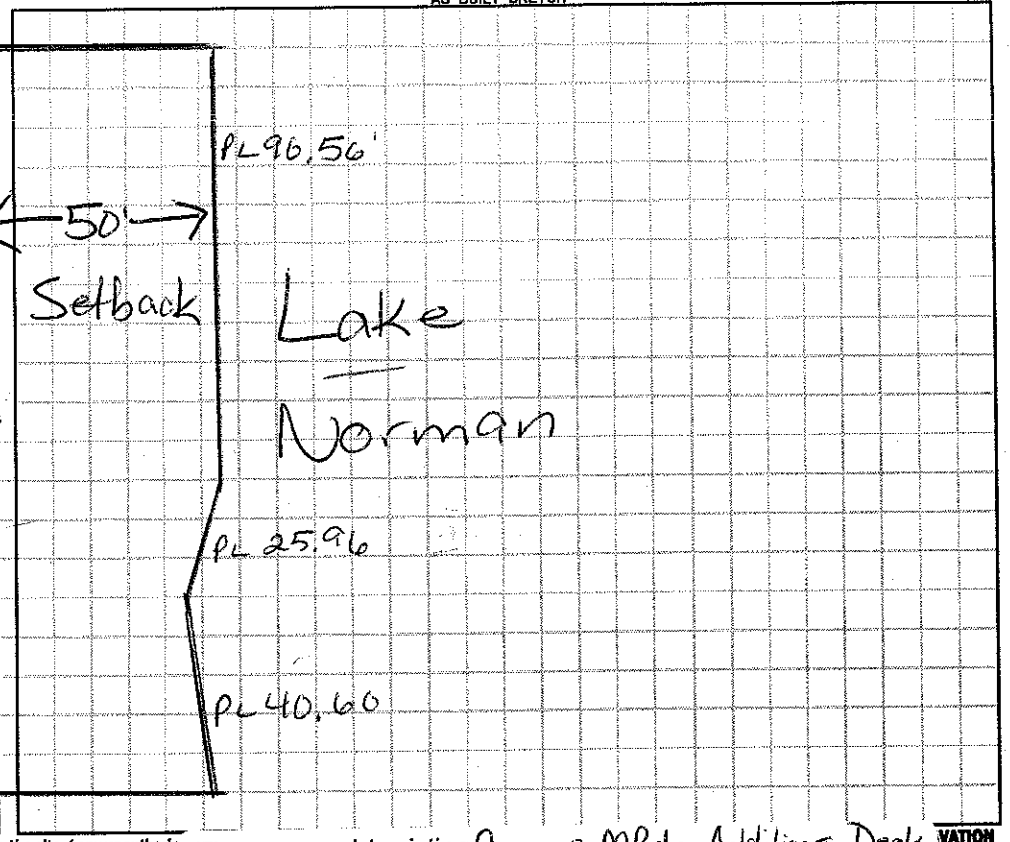

Permit can be suspended or revoked if any false information is supplied toward securing the permit / any unauthorized changes are made to the site / any unauthoriz

☐ IMPROVEMENT PERMIT *with plat* valid without expiration. ☐ IMPROVEMENT PERMIT *with site plan* valid for 60 mos. ☐ I VATION 60 mo.

The proposed / existing ~~Garage~~ MBdrm Addition & Deck addition does not appear to impact the existing septic system.
**NOTE: Must keep any Building Foundation at least 5FT from Septic

Owner / Applicant Signature: Sherry Garner Date: 7-1-14 Installed by:

IMPROVEMENT PERMIT by: Date: OPERATION PERMIT

AUTHORIZATION TO CONSTRUCT by: Date: Existing System Ins

Maria Dotson R.S.
Date: 5-15-14
ICHD-Environmental Health Division

Health Dept. Copy - WHITE Applicant (Final Approval) - YELLOW Applicant (Conditional Approval) - PINK