IREDELL COUNTY HEALTH DEPARTMENT

STATESVILLE 704-878-5305 MOORESVILLE 704-664-5281

IMPROVEMENT PERMIT / AUTHORIZATION TO CONSTRUCT / OPERATION PERMIT / EXISTING SYSTEM INSPECTION

PERMIT# 106440 PIN# ~~4624377983~~ 4624377962 DATE 7/5/02

OWNER OR CONTRACTOR CRESCENT RESOURCES / Hughes, Hamelink & Zander Business 660-1185 Home

ADDRESS PO BOX 1003 CHARLOTTE NC 28201

LOCATION BRAWLEY SCHOOL - TL GREYFRIARS - 3RD ON RT 120 Greyfriars Rd

SUBDIVISION ~~The Point~~ The Point BLOCK / SECTION ~~86~~ LOT 1745 LOT AREA .86AC SITE CLASS PS DESIGN FLOW 360GPD L.T.A.R. ~.25GPD/FT2

Septic Tank: 1000T Gallons; STB 338 Date 7-11-05

Pump Tank: 1000T Gallons; PT 283 Date 7-10-05

Pump Make: Goulds Model 10E6S12HHBF No. G0562348

Nitrification Field: No Fields 1 Square Feet 1470 Linear Feet 490

No Lines 7@70' Trench Width 36" Max Trench Bottom Depth 36" Gravel Depth N/A

☑ New System ☐ Repair System Type: I, II, III, IV, V, VI

System Description: PUMP 25% REDUCTION

Repair System Description: SAME

Maintenance Agreement Required: ☐ Yes ☑ No

☑ House/Mod. Home ☐ Mobile Home ☐ Business ☐ Other

No. Bedrooms 4 No. Bathrooms 4 No. Employees

☐ Slab ☐ Crawl Space ☑ Basement w/plumbing ☐ Basement wo/plumbing

Water Supply: ☐ Individual ☐ Public ☑ Community


Comments/Conditions: Reviewed Building plans & Site plan, essentially in Compliance with original permit.

Comments/Conditions: OFFSITE


Lines checked 8/4/05; Supply lines checked 8/5/05

Tanks Checked 8/16/05

1"=100' INITIAL SITE SKETCH

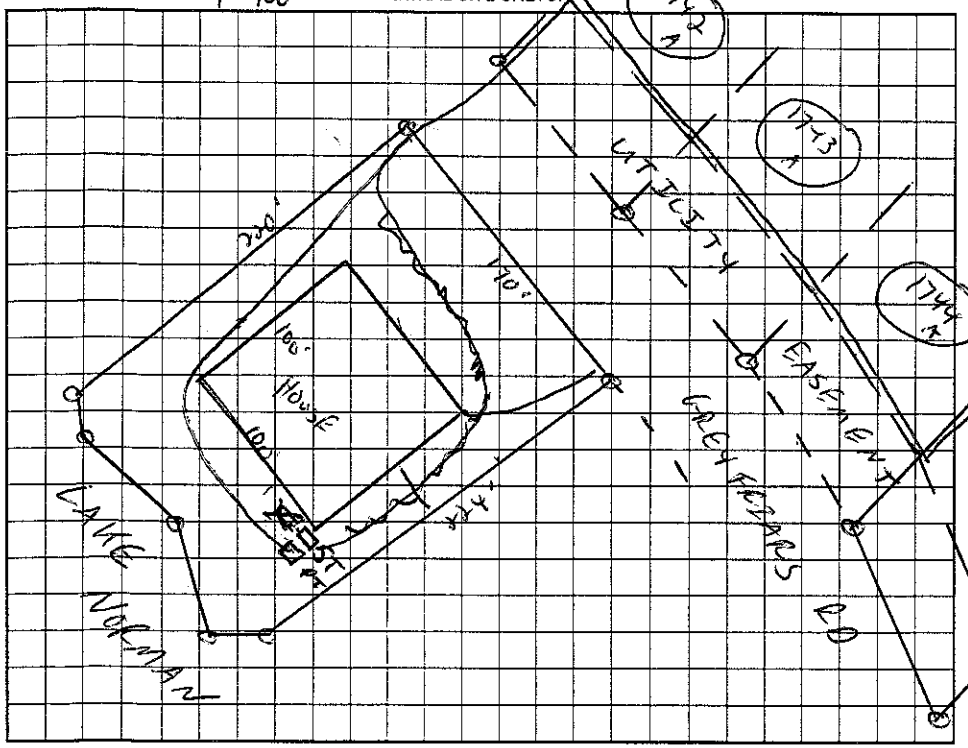

AS BUILT SKETCH

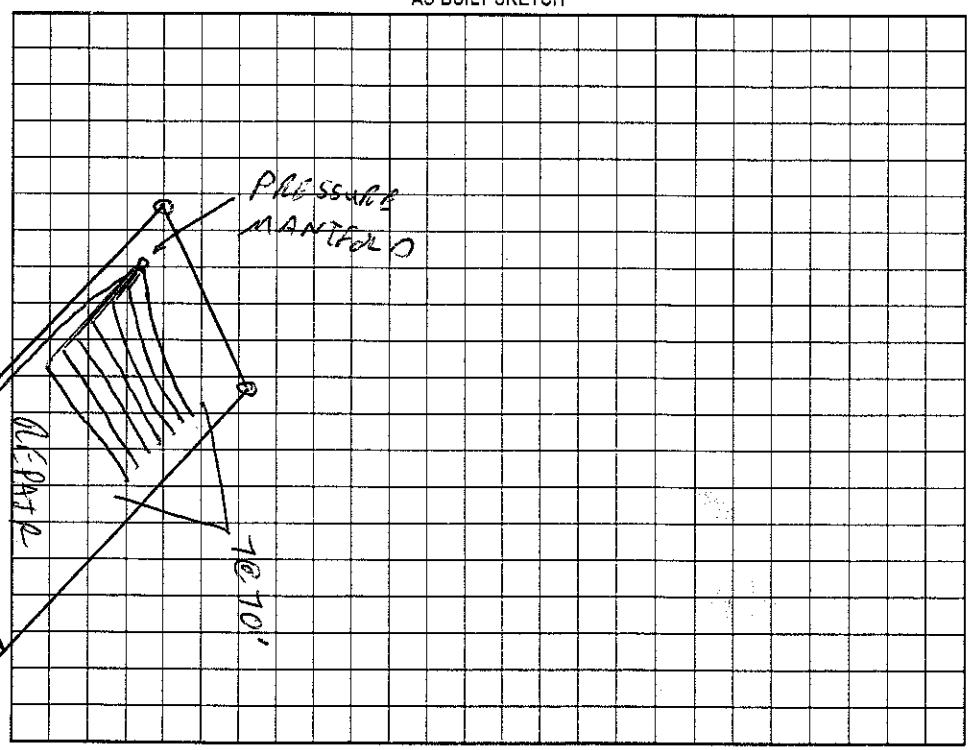

Permit can be suspended or revoked if any false information is supplied toward securing the permit/any unauthorized changes are made to the site/any unauthorized changes are made in the installation of the system. Improvement Permit with plat valid without expiration. Improvement Permit with site plan valid for sixty months. Authorization to Construct is valid for a period equal to that of Improvement Permit – not to exceed sixty months.

Signed: Tony Martin, RS date 7/9/02

Improvement Permit by: RS date 7/15/02

Authorization to Construct by: Maria H. Dotson RS date 2/24/05

Installed by: Bobby Mayhew RS

Operation Permit by: Maria H. Dotson date 9/23/05

Existing System Inspection by: date

HEALTH DEPT. COPY: WHITE OWNER COPY (FINAL): YELLOW OWNER COPY (INITIAL): PINK