IREDELL COUNTY HEALTH DEPARTMENT

STATESVILLE 704-878-5305 MOORESVILLE 704-664-5281

IMPROVEMENT PERMIT / AUTHORIZATION TO CONSTRUCT / OPERATION PERMIT / EXISTING SYSTEM INSPECTION

#375.00 Paid 380

PERMIT# 135338 PIN# 4624379814 DATE 5-10-06

OWNER OR APPLICANT Ryan-West PHONE: Business 799-8641 Home

ADDRESS 127B Promenade Drive Mooresville, NC 28117

LOCATION Brawley School Rd TL Greyfriars on right

SUBDIVISION C1a T BLOCK / SECTION 6 LOT 523 LOT AREA .719 Acre SITE CLASS. PS DESIGN FLOW 480gpd L.T.A.R. .3

Septic Tank: 1000 Gallons; STB 1000T Date 9-11-06
Pump Tank: 1000 Gallons; PT 274 Date 10-20-06
Pump Make Zoeller Model N152 Serial No.
Nitrification Field: No Fields 1 Square Feet Linear Feet 269
No Lines 3 Trench Width *See note Max Trench Bottom Depth 36 Gravel Depth N/A

☒ New System ☐ Repair ☐ Expansion System Type: I II III IV V VI
System Description: Pump-LP-Panel Black
Repair System Description: same
Maintenance Agreement Required: ☒ Yes ☐ No

☒ House/Mod. Home No. Bedrooms 4
☐ Mobile Home No. Persons
☐ Business No. Employees
☐ Other


Water Supply: ☒ Individual ☐ Public ☐ Community

☐ Gravity ☒ Pressure ☐ Slab ☐ Crawl Space ☒ Basement w/plumbing ☐ Basement wo/plumbing


Comments:/Conditions: *Note: For trench width see "Fast track" report submitted by Rollans Soil & Environmental Services
*Use in line Filter in PT

Comments:/Conditions: Arched Opening in Office.
*Okay to use 24" trench width.
Checked 5/lower 2 lines 1/4/06
Drilled 5/32 hole

INITIAL SITE SKETCH

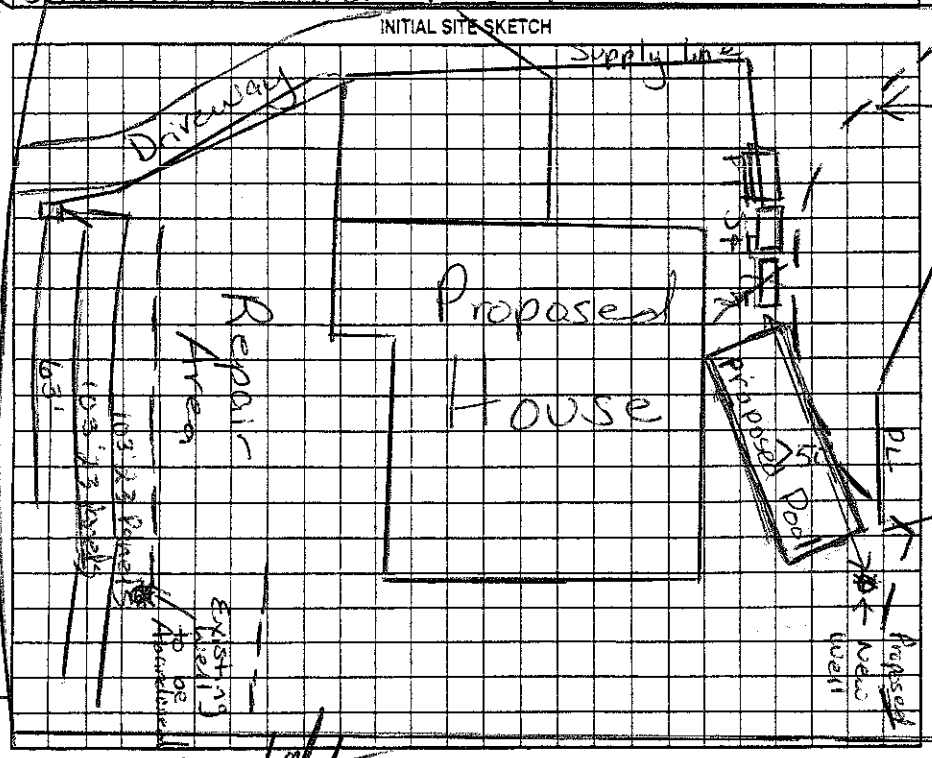

AS BUILT SKETCH

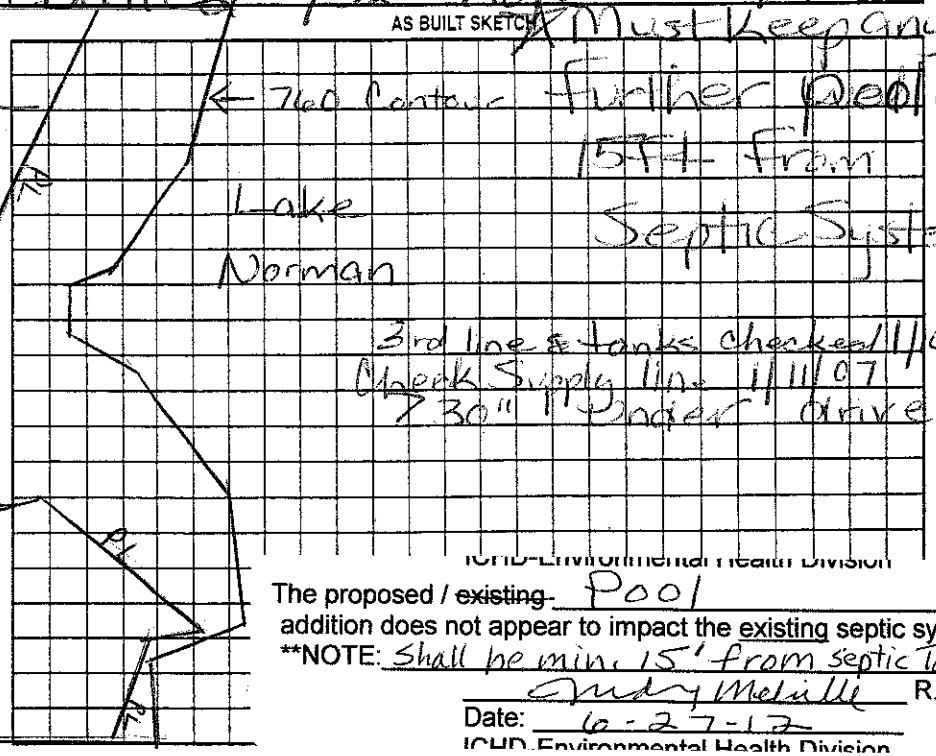

Must keep any further pool cut 15FT from Septic System.

3rd line & tanks checked 11/0/07
Check Supply line 11/11/07
30" Pipe under drive

ICHD-Environmental Health Division

The proposed / ~~existing~~ Pool addition does not appear to impact the existing septic system.
**NOTE: Shall be min. 15' from septic tanks
Cindy Melville R.S.
Date: 6-27-12
ICHD-Environmental Health Division

Permit can be suspended or revoked if any false information is supplied toward securing the permit/any unauthorized changes are made to the site/any unauthorized changes are made in the installation of the system. Improvement Permit with plat valid with no expiration ☐ Improvement Permit with site plan valid for sixty months ☐ Authorization to Construct is valid for a period equal to that of Improvement Permit – not to exceed sixty months.

Signed: date 5/16/06 Installed by: Wayne Plantz

Improvement Permit by: Maria H. Thompson RS date 5/10/06 Operation Permit by: Wesley Sparks RS. date 4/11/07

Authorization to Construct by: Maria H. Thompson RS date 5/16/06 Existing System Inspection by: date

HEALTH DEPT. COPY: WHITE OWNER COPY (FINAL): YELLOW OWNER COPY (INITIAL): PINK