IREDELL COUNTY HEALTH DEPARTMENT
STATESVILLE 704-878-5305 MOORESVILLE

IMPROVEMENT PERMIT / AUTHORIZATION TO CONSTRUCT / OPERATION PERMIT / EXISTING SYSTEM

PERMIT# 105418 PIN# 4624 275905. 950 4674-38-5578 DATE 5/21/02

OWNER OR CONTRACTOR POINT ON NORMAN / Arcadia Homes PHONE: Business 660-1185 Home

ADDRESS 2214 BRAWLEY SCHOOL - MOORESVILLE 28117

LOCATION BRAWLEY SCHOOL - TR 1ST MANSFIELD - SEPTIC EASEMENT ON LT CORNER - LOT ON RT CORNER

SUBDIVISION POINT BLOCK / SECTION 9 LOT 950 LOT AREA 1.09AC SITE CLASS. PS DESIGN FLOW 480610 L.T.A.R. .25 gal/sq ft

Septic Tank: 1000 + Gallons; STB 444 Date 2-1-06
Pump Tank: 1000+ Gallons; PT 27 Date 7-13-05
Pump Make: Goulds Model WE03 12M Serial No.
Nitrification Field: No Fields 1 Square Feet 1440 Linear Feet 480
No Lines 6@80' Trench Width 36" Max Trench Bottom Depth 36" Gravel Depth N/A

☑ New System ☐ Repair System Type: I, II, III, IV, V, VI
System Description: PUMP 25% REDUCTION
Repair System Description: LP PANEL
Maintenance Agreement Required: ☐ Yes ☑ No


☑ House/Mod. Home No. Bedrooms 4
☐ Mobile Home No. Bathrooms 4
☐ Business No. Employees
☐ Other
☐ Slab ☑ Crawl Space ☐ Basement w/plumbing ☐ Basement wo/plumbing

Water Supply: ☐ Individual ☐ Public ☑ Community


Comments:/Conditions:

Comments:/Conditions: Checked Drainfield 3/17/06
Checked tanks 3/24/06

1" = 100' INITIAL SITE SKETCH

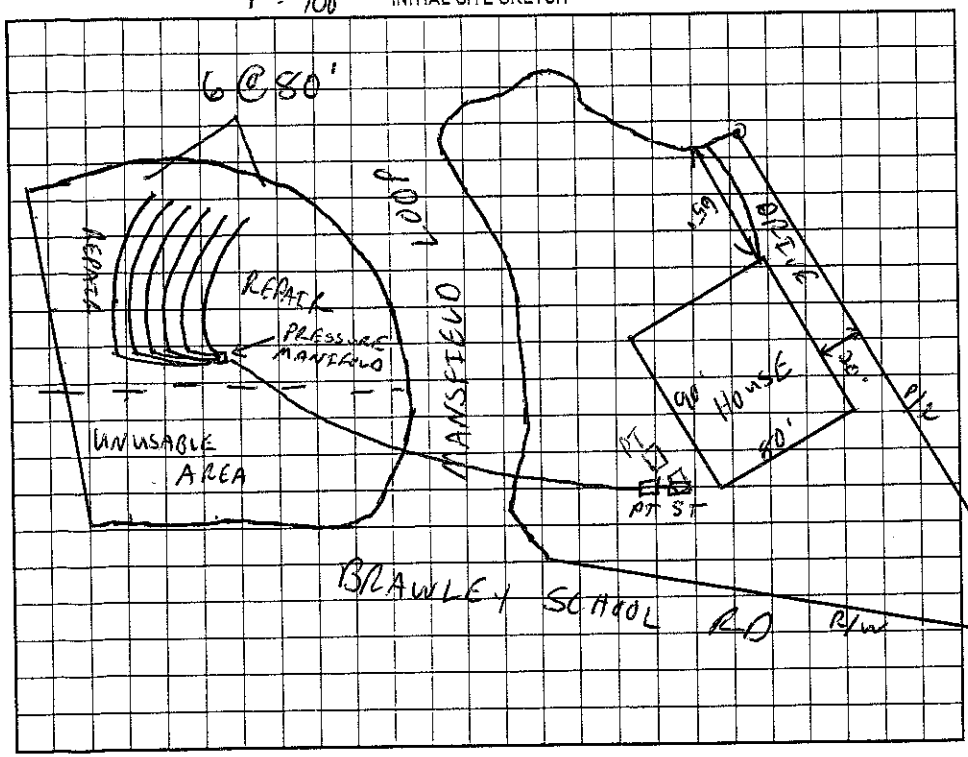

AS BUILT SKETCH

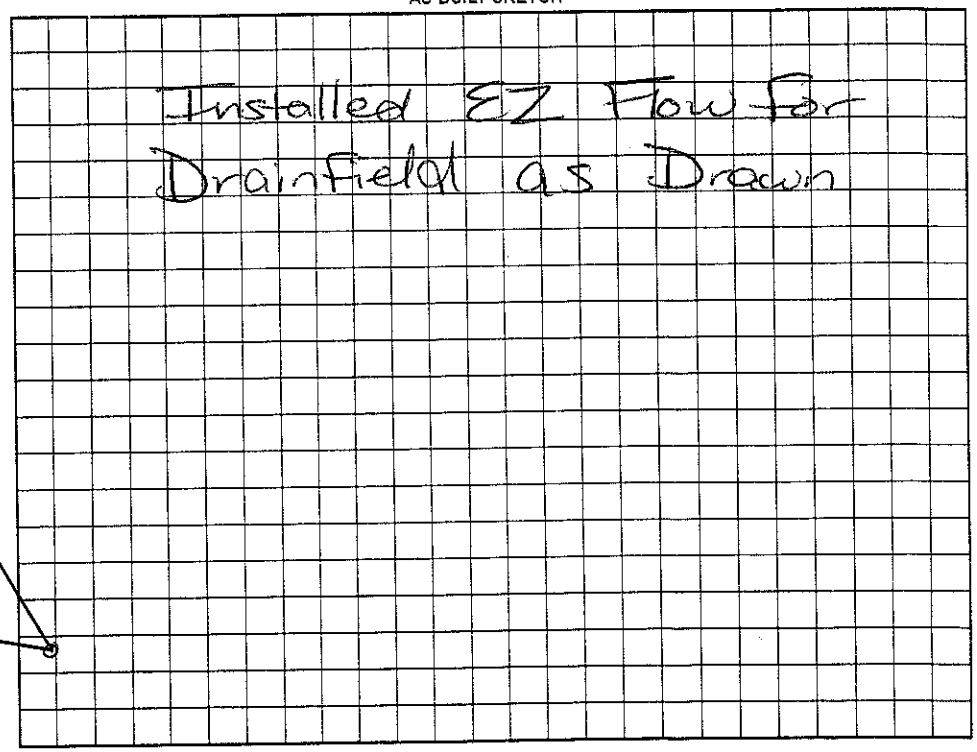

Permit can be suspended or revoked if any false information is supplied toward securing the permit/any unauthorized changes are made to the site/any unauthorized changes are made in the installation of the system. Improvement Permit with plat valid without expiration. Improvement Permit with site plan valid for sixty months. Authorization to Construct is valid for a period equal to that of Improvement Permit – not to exceed sixty months.

Signed: date 5-23-02 Installed by: RS

Improvement Permit by: RS date 5/21/02 Operation Permit by: RS date 7/5/06

Authorization to Construct by: RS date 8/31/05 Existing System Inspection by: date

HEALTH DEPT. COPY: WHITE OWNER COPY (FINAL): YELLOW OWNER COPY (INITIAL): PINK