3130

# IREDELL COUNTY HEALTH DEPARTMENT

STATESVILLE 704-878-5305 MOORESVILLE 704-664-5281

## IMPROVEMENT PERMIT / AUTHORIZATION TO CONSTRUCT / OPERATION PERMIT / EXISTING SYSTEM INSPECTION

PERMIT# 105423 PIN# 4624 275905.952 4624-38-5879 DATE 5/3/02

OWNER OR CONTRACTOR POINT ON NORMAN / Arcadia PHONE: Business 660-1185 Home

ADDRESS 2214 BRAWLEY SCHOOL RD MOORESVILLE 28117

LOCATION BRAWLEY SCHOOL - TR MANSFIELD - TR FINCHBURG - ON LT

SUBDIVISION POINT BLOCK / SECTION 9 LOT 952 LOT AREA 1.34C SITE CLASS. PS DESIGN FLOW 480GPD L.T.A.R. .25gpd/ft²

Septic Tank: 1000+ Gallons; STB 338 Date 7-29-06

Pump Tank: Gallons; PT Date

Pump Make: Model Serial No.

Nitrification Field: No Fields 1 Square Feet 1440 Linear Feet 480

No Lines 4@120' Trench Width 36" Max Trench Bottom Depth 36"

☑ New System ☐ Repair System Type: I, II, (III), IV, V, VI

System Description: GRAVITY INNOVATIVE

Repair System Description: LP PANEL

Maintenance Agreement Required: ☐ Yes ☑ No

Gravel Depth N/A

☑ House/Mod. Home No. Bedrooms 4

☐ Mobile Home No. Bathrooms 4

☐ Business No. Employees

☐ Other


☐ Slab ☑ Crawl Space ☐ Basement w/plumbing ☐ Basement wo/plumbing

Water Supply: ☐ Individual ☐ Public ☑ Community

Comments:/Conditions:

Comments:/Conditions: Checked ST & drainfield

INITIAL SITE SKETCH

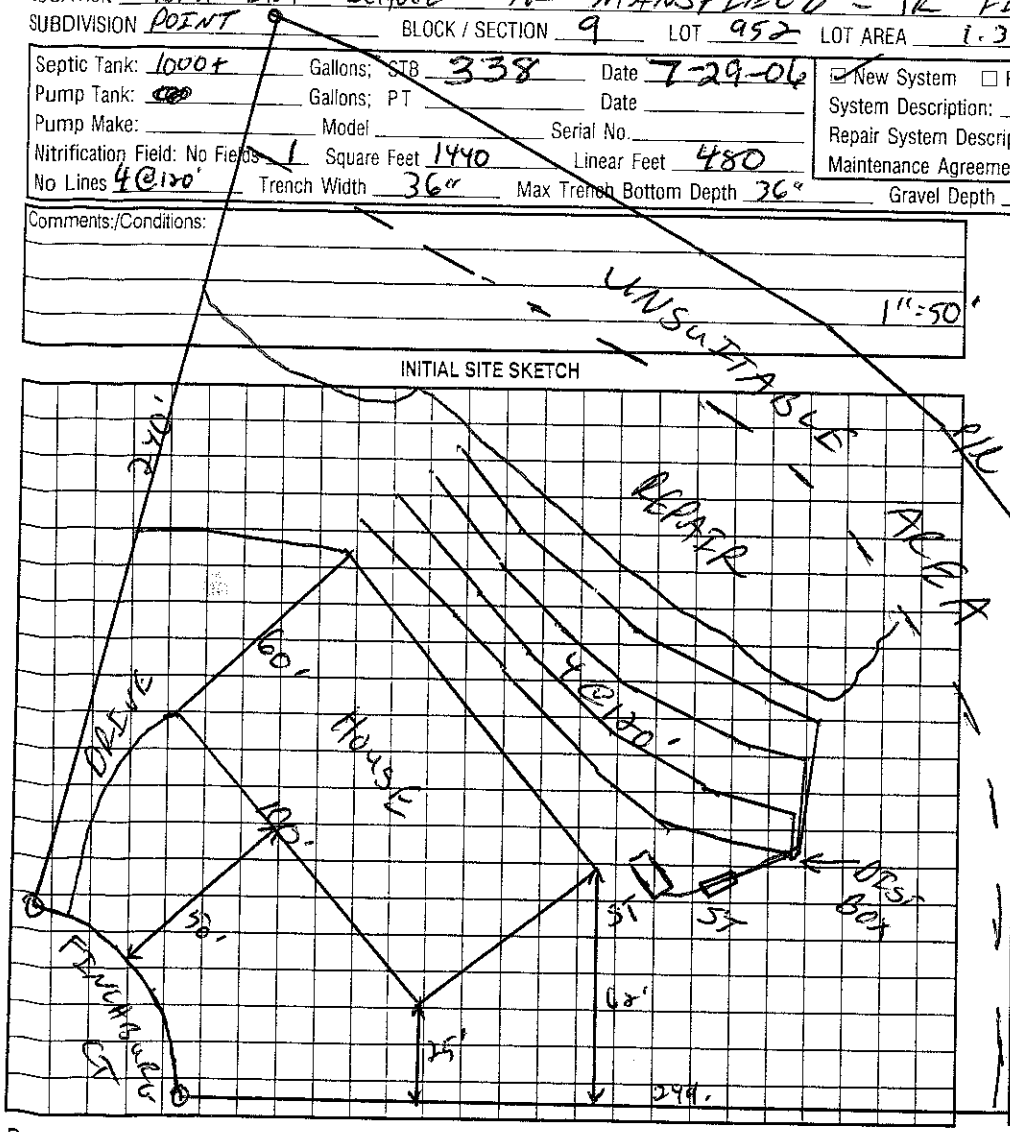


AS BUILT SKETCH

Installed EZ Flow as Drawn

Permit can be suspended or revoked if any false information is supplied toward securing the permit/any unauthorized changes are made to the site/any unauthorized changes are made in the installation of the system. Improvement Permit with plat valid without expiration. Improvement Permit with site plan valid for sixty months. Authorization to Construct is valid for a period equal to that of Improvement Permit – not to exceed sixty months.

Signed: date 5-23-02

Improvement Permit by: RS date 5/3/02

Authorization to Construct by: Jerry McNeill date 5-3-06

Installed by: R & H RS date 9/8/06

Operation Permit by: date

Existing System Inspection by: date

HEALTH DEPT. COPY: WHITE OWNER COPY (FINAL): YELLOW OWNER COPY (INITIAL): PINK