IREDELL COUNTY HEALTH DEPARTMENT

STATESVILLE 704-878-5305 MOORESVILLE 704-664-5281

IMPROVEMENT PERMIT / AUTHORIZATION TO CONSTRUCT / OPERATION PERMIT / EXISTING SYSTEM INSPECTION

PERMIT # 153410 PIN # 4624386034 DATE 11/7/08

OWNER or APPLICANT Ken Beaver Homes PHONE: Business 704.622.4659 Home: Same

OWNER or APPLICANT ADDRESS 1454 Brawley School Rd. Mooresville, NC 28117

LOCATION / DIRECTIONS Brawley School Rd., TL Greenfields, 2nd lot on left

SUBDIVISION ~~The Point~~ CL-4T BLOCK / SECTION 12 LOT # 1744 LOT AREA 0.41 acres DESIGN FLOW 600 gpd L.T.A.R. 0.25

Septic Tank 1500 Gallons: STB 4417 Date 6-14-10

Pump Tank 1500 Gallons: PT 4T Date 7-26-10

Pump Make Myers Model P102 Serial #

Nitrification Field No Fields 1 No Lines 7 Linear Feet 600

Trench Width 36" Max. Trench Bottom Depth 36" Gravel Depth —

☑ New System ☐ Repair ☐ Expansion System Type I II III IV V VI

System Description: Pump 25%

Repair System Description: LP PPBPS

Maintenance Agreement Required ☐ YES ☑ NO

☐ GRAVITY ☑ PRESSURE

☑ Residence No. Bedrooms 5

☐ Business No. Persons

☐ Other No. Employees

☐ Slab ☐ Crawl Space

☑ Basement w/plumbing ☐ Basement w/o plumbing

Water Supply: ☐ Private ☐ Public ☑ Community


Comments / Conditions * Pumping to offsite easement

* maintain all setbacks, install on contour


Comments / Conditions 8/11/2010 Checked Drainfield

8/31/10 Checked Tanks

INITIAL SITE SKETCH

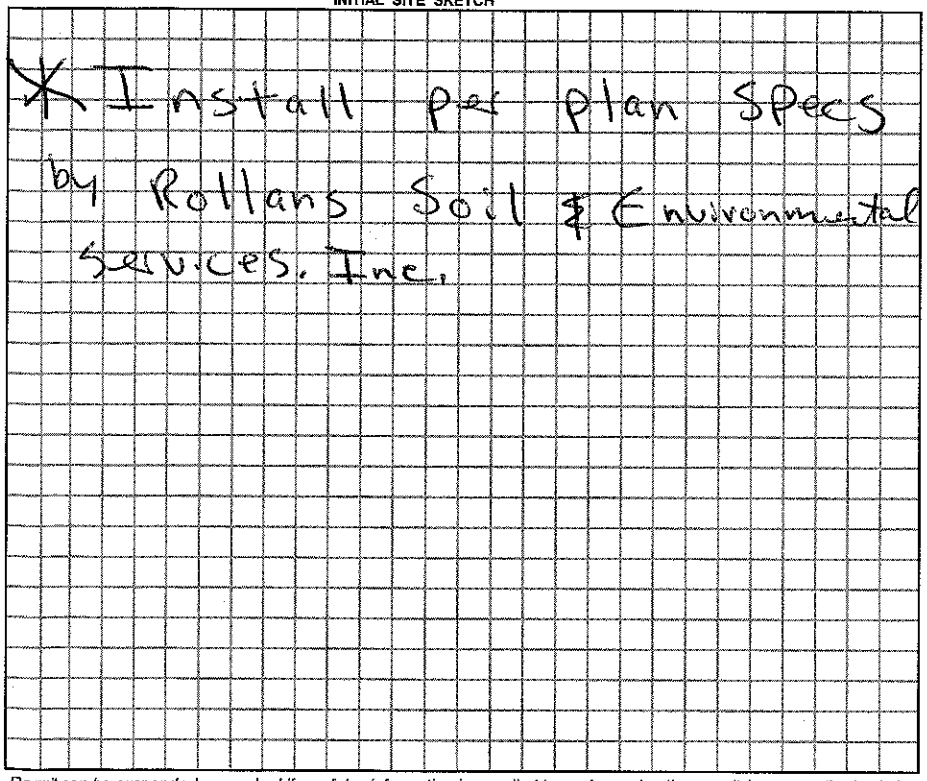

AS BUILT SKETCH

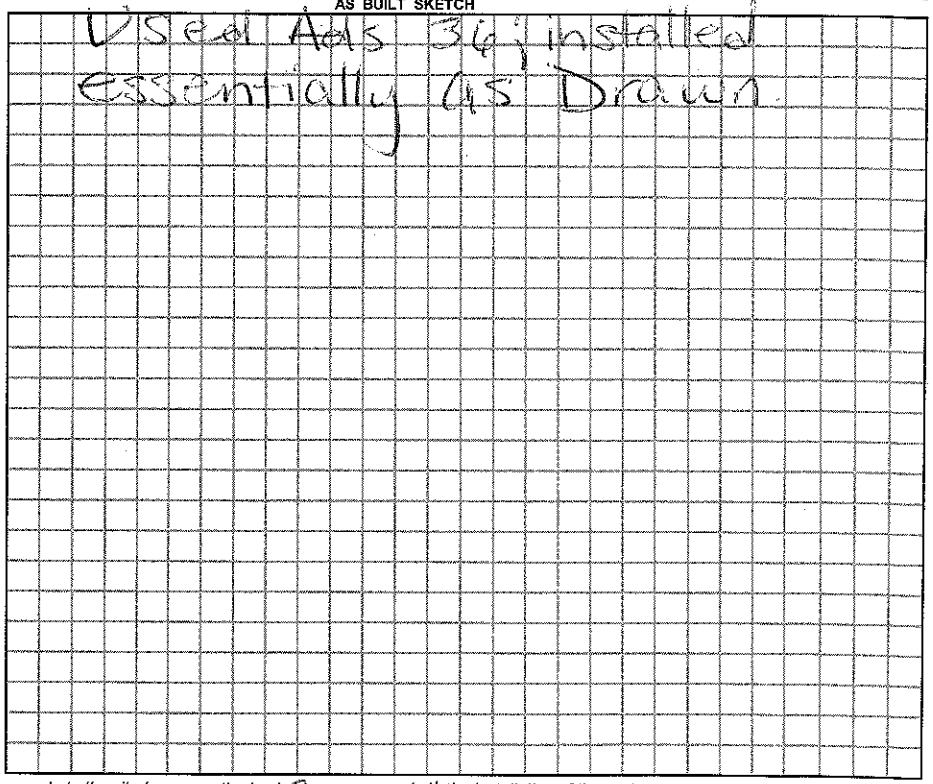

Permit can be suspended or revoked if any false information is supplied toward securing the permit / any unauthorized changes are made to the site / any unauthorized changes are made in the installation of the system.

☐ *IMPROVEMENT PERMIT w / plat valid without expiration.* ☑ *IMPROVEMENT PERMIT w / site plan valid for 60 mos.* ☒ *AUTHORIZATION TO CONSTRUCT valid for period equal to IMPROVEMENT PERMIT-not to exceed 60 mo.*

Owner / Applicant Signature: Kim Beaver Date 12-15-08

Improvement Permit by: [signature] Date 11/7/08

Authorization to Construct by: [signature] REHS Date 1-13-09

YOU SHOULD CONTACT A LOCATOR SERVICE PRIOR TO ANY EXCAVATION.

Installed by: R & T KS

Operation Permit by: [signature] Date: 9/22/2010

Existing System Inspected by: Date:

WHITE COPY Environmental Health YELLOW COPY (Final) Owner / Applicant PINK COPY (Initial) Owner / Applicant