IREDELL COUNTY HEALTH DEPARTMENT

Statesville Office (704) 878-5305 Mooresville Office (704) 660-3625 PERMIT # 205237

IMPROVEMENT PERMIT / AUTHORIZATION TO CONSTRUCT / OPERATION PERMIT / EXISTING SYSTEM

PIN # 4624387373

APPLICANT: Donald Skalsky APPLICANT ADDRESS: 11555 Ascot Ln Chagrin OH 44023

SITE ADDRESS: 1106 Torrence Chapel Rd. PHONE: 704-576-3587 ALT. PHONE: N/A

SITE DIRECTIONS: Brawley School Rd T/L Torrence Chapel, 1st on Right

SUBDIVISION: The Point Phase II SECTION N/A LOT # 1101 LOT AREA: 2.164ac DESIGN FLOW: 600 L.T.A.R.: 0.3

Septic Tank 1500 (gal) STB 338 Date 5/16/15
Pump Tank (gal) PT Date
Pump Make Model Serial #
Nitrification Fields 1 # Lines 4 Linear Ft: 500
Trench Width 36" Max. Trench Bottom Depth 36" Gravel Depth N/A

[X] New System [ ] Repair [ ] Expansion System Type: I II [III] IV V VI
System Description: 25% Reduction
Repair System Description: 50% Reduction
Maintenance Agreement Required: [ ] YES [X] NO
[X] GRAVITY [ ] PRESSURE

[X] Residence No. Bedrooms 5
[ ] Business No. Persons 10
[ ] Other No. Employees
[ ] Slab [X] Crawl Space
[ ] Basement w/plumbing [ ] Basement w/o plumbing

Water Supply: [ ] Private [ ] Public [X] Community

Comments / Conditions: Install per site plan by Michael Athanas & Associates.

INITIAL SITE SKETCH

See site plan by Michael Athanas & Associates

AS BUILT SKETCH

Installed As Drawn.
Quick 4 Chambers

* Tank Location Changed. Extra Repair Laid Out. Should not Effect System.

Permit can be suspended or revoked if any false information is supplied toward securing the permit / any unauthorized changes are made to the site / any unauthorized changes are made in the installation of the system. **CONTACT A LOCATOR SERVICE PRIOR TO ANY EXCAVATION**

[ ] **IMPROVEMENT PERMIT** *with plat valid without expiration.* [X] **IMPROVEMENT PERMIT** *with site plan valid for 60 mos.* [X] **AUTHORIZATION TO CONSTRUCT** *valid for period equal to IMPROVEMENT PERMIT--not to exceed 60 mo.*


Owner / Applicant Signature: Donald Skalsky Date: 9/11/14 Installed by: Richard Abernathy

IMPROVEMENT PERMIT by: Date: 08/18/14 OPERATION PERMIT by: APPROVED Date: JUL 28 2015

AUTHORIZATION TO CONSTRUCT by: Date: 9-10-14 Existing System Inspected by: Date:

Health Dept. Copy - WHITE Applicant (Final Approval) - YELLOW Applicant (Conditional Approval) - PINK

Arthur Rutenberg Homes

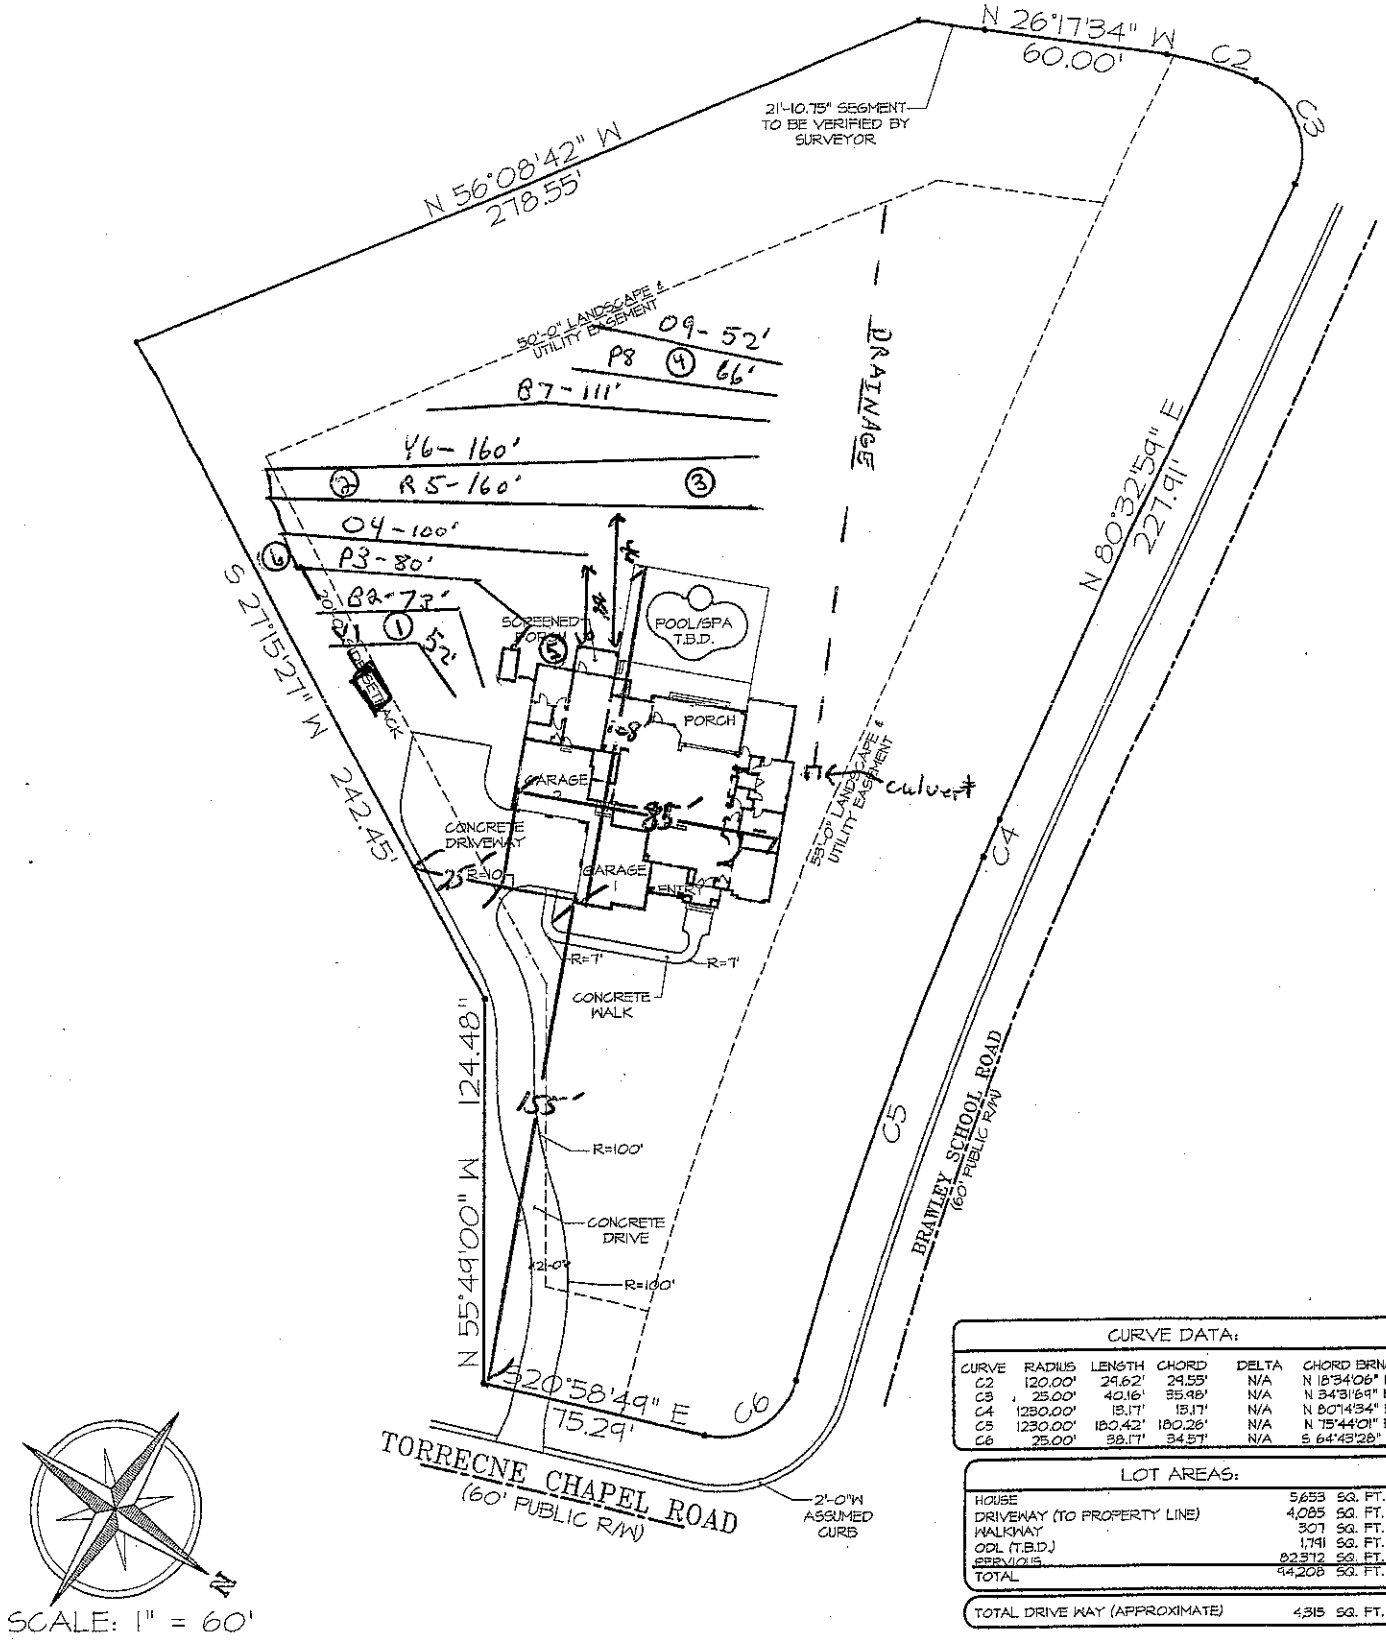

SCALE: 1" = 60'

CURVE DATA:

CURVE	RADIUS	LENGTH	CHORD	DELTA	CHORD BRNG
C2	120.00'	24.62'	24.55'	N/A	N 15°34'06" W
C3	25.00'	40.16'	35.98'	N/A	N 34°31'59" E
C4	1230.00'	18.17'	18.17'	N/A	N 80°14'34" E
C5	1230.00'	180.42'	180.26'	N/A	N 75°44'01" E
C6	25.00'	38.17'	34.57'	N/A	S 64°43'28" E

LOT AREAS:

HOUSE	5,653 SQ. FT.
DRIVEWAY (TO PROPERTY LINE)	4,085 SQ. FT.
WALKWAY	307 SQ. FT.
ODL (T.B.D.)	1,791 SQ. FT.
PERVIOUS	82,312 SQ. FT.
TOTAL	94,208 SQ. FT.

TOTAL DRIVE WAY (APPROXIMATE) 4,315 SQ. FT.

Note: Plan information is conceptual only. Certain items may be changed at production stage. Clouded areas modified to accommodate change requests.

Franchise: #98 Bluefield Builders, LLC
File # : Skalsky-C2 1222F-R-02-2S/2F-"B"
Drawn By: MDG
Date: June 4, 2014

A Custom Residence for:

DJ & Liz Skalsky

The Point at Lake Norman, Lot 1101