IREDELL COUNTY HEALTH DEPARTMENT

STATESVILLE 704-878-5305 MOORESVILLE 704-664-5281

IMPROVEMENT PERMIT / AUTHORIZATION TO CONSTRUCT / OPERATION PERMIT / EXISTING SYSTEM INSPECTION

PERMIT# 105421 PIN# ~~4624 27 5905 451~~ 4624387658 DATE 5/3/02

OWNER OR CONTRACTOR ~~THE POINT ON NORMAN~~ LK NORMAN SIGNATURE PHONE: Business 660-1185 Home

ADDRESS 2214 BRAWLEY SCHOOL RD MOORESVILLE NC 28115

LOCATION BRAWLEY SCHOOL - TR MANSFIELD - TR FINCHBURG CT - ON RT #110 Fitchburg

SUBDIVISION THE POINT BLOCK / SECTION 9 LOT 951 LOT AREA 1.884C SITE CLASS. PS DESIGN FLOW 480GPD L.T.A.R. .29/1.19

Septic Tank: 1000+ Gallons; STB 335 Date 12-19-06 ☑ New System ☐ Repair System Type: I, II, III, IV, V, VI ☑ ~~House/Mod. Home~~ No. Bedrooms 4

Pump Tank: 1000+ Gallons; PT 37.25 Date System Description: PUMP INNOVATIVE ☐ Mobile Home No. Bathrooms 4

Pump Make Goulds Model CWE0312M Serial No. LA07452 Repair System Description: LP PANEL ☐ Business No. Employees

Nitrification Field: No Fields 1 Square Feet 1800 Linear Feet 600 Maintenance Agreement Required: ☐ Yes ☑ No ☐ Other

No Lines 5@120' Trench Width 36" Max Trench Bottom Depth 36" Gravel Depth N/A ☐ Slab ☑ Crawl Space ☐ Basement w/plumbing ☐ Basement wo/plumbing


Water Supply: ☐ Individual ☐ Public ☑ Community

Comments:/Conditions:


Comments:/Conditions: Installed EZ Flow as Drawn

Checked Tanks, lines & pressure 1/29/06

1"=50' INITIAL SITE SKETCH

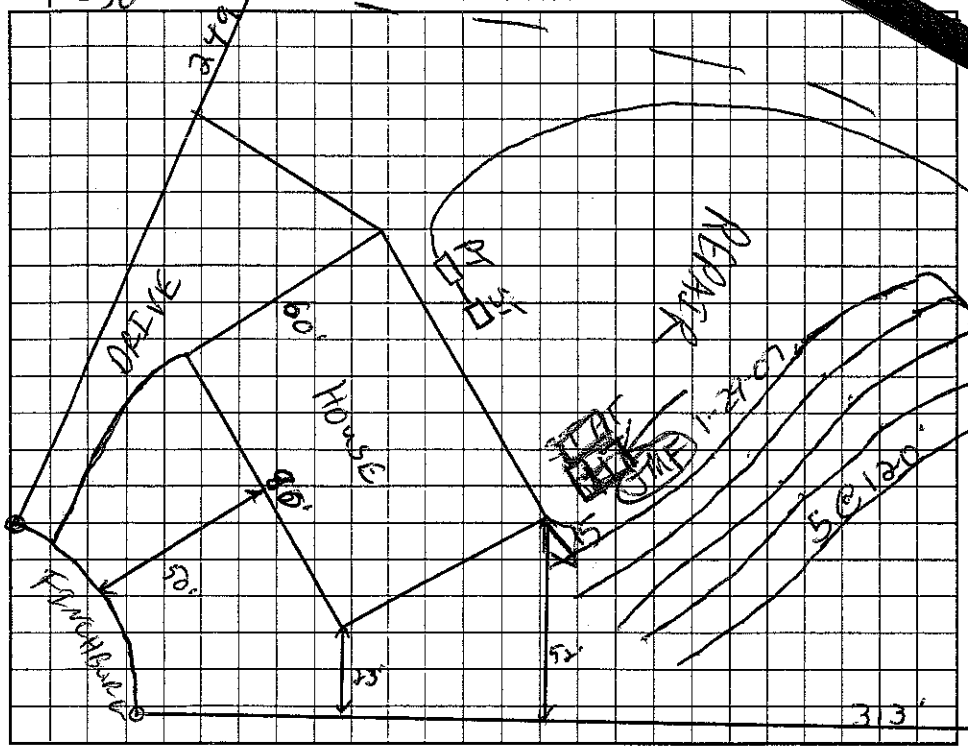

AS BUILT SKETCH

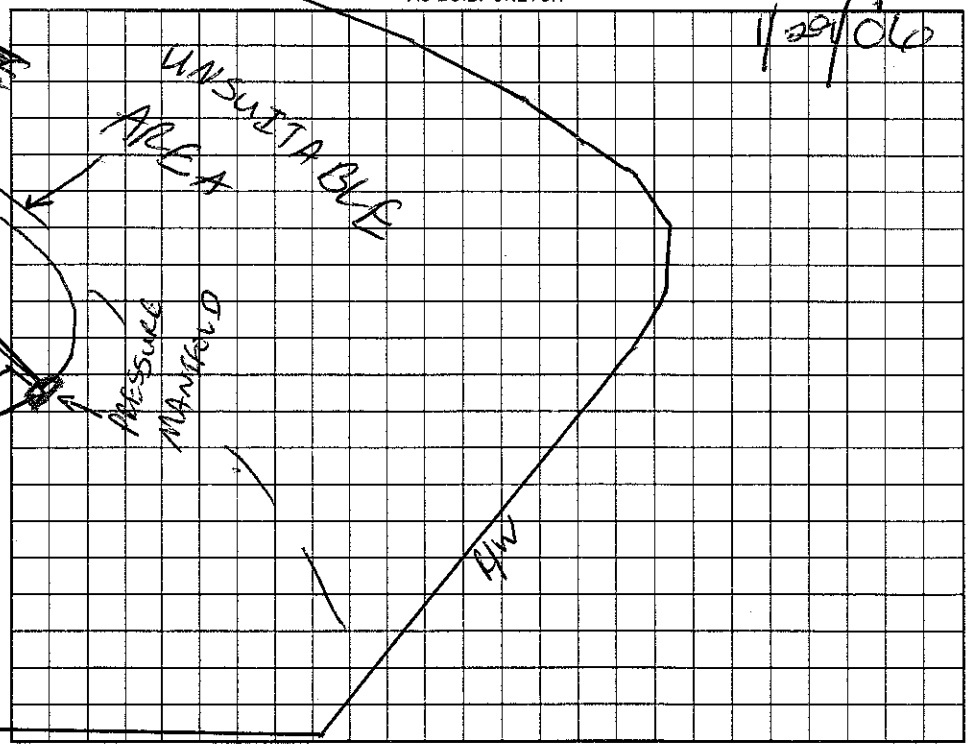

Permit can be suspended or revoked if any false information is supplied toward securing the permit/any unauthorized changes are made to the site/any unauthorized changes are made in the installation of the system. Improvement Permit with plat valid without expiration. Improvement Permit with site plan valid for sixty months. Authorization to Construct is valid for a period equal to that of Improvement Permit – not to exceed sixty months.

Signed: [signature] date 5-23-02 Installed by: Hallman Construction

Improvement Permit by: [signature] RS date 5/3/02 Operation Permit by: Wesley Sparks RS date 3/8/07

Authorization to Construct by: Wesley Sparks RS date 3/21/06 Existing System Inspection by: date

HEALTH DEPT. COPY: WHITE OWNER COPY (FINAL): YELLOW OWNER COPY (INITIAL): PINK