MW

ICHD - ENVIRONMENTAL HEALTH DIVISION

Statesville Office (704) 878-5305 | Mooresville Office (704) 660-3625 PERMIT # 2023-16030

SEPTIC: IMPROVEMENT PERMIT / AUTHORIZATION TO CONSTRUCT / OPERATION PERMIT / EXISTING SYSTEM

PIN # 4624 -- 38 -- 9961

APPLICANT/OWNER: Jeanie Lentz APPLICANT ADDRESS: 463 Lentz Rd, Statesville

SITE ADDRESS: 114 Stonemarker Rd, Mooresville 28117 PHONE: 980-829-3278 ALT. PHONE -

SITE DIRECTIONS: Brawley School - Stonemarker SAP CONTROLLED: ☐ YES ☐ NO

SUBDIVISION: CL&T SECTION: 6 LOT # 1610 LOT AREA: 1.24 acres DESIGN FLOW: EX L.T.A.R.: EX


Septic Tank	1000 (gal)	STB 760	Date 2/23/23	☐ New System ☒ Repair ☐ Expansion	System Type: I II III (IV) V VI	☒ Residence	No. Bedrooms EX	Water Supply
Pump Tank	1000 (gal)	PT 363	Date 3/12/23	System Description: -		☐ Business	No. Persons EX	☒ Private
Pump Make		Model	Serial #	Repair System Description: Tank Replacement		☐ Other	No. Employees	☐ Public
# Nitrification Fields	EX	# Lines EX	Linear Ft EX	Maintenance Agreement Required:	☒ YES ☐ NO	☐ Slab	☐ Crawl Space	☐ Community
Trench Width	EX	Trench Bottom Depth(Low side)	EX	Gravel Depth -	☐ GRAVITY ☒ PRESSURE	☒ Basement w/plumbing		☐ Basement w/o plumbing

Comments / Conditions: Pump, crush, & fill old tank. Verify supply line is 50' from well.

INITIAL SITE SKETCH



AS BUILT SKETCH

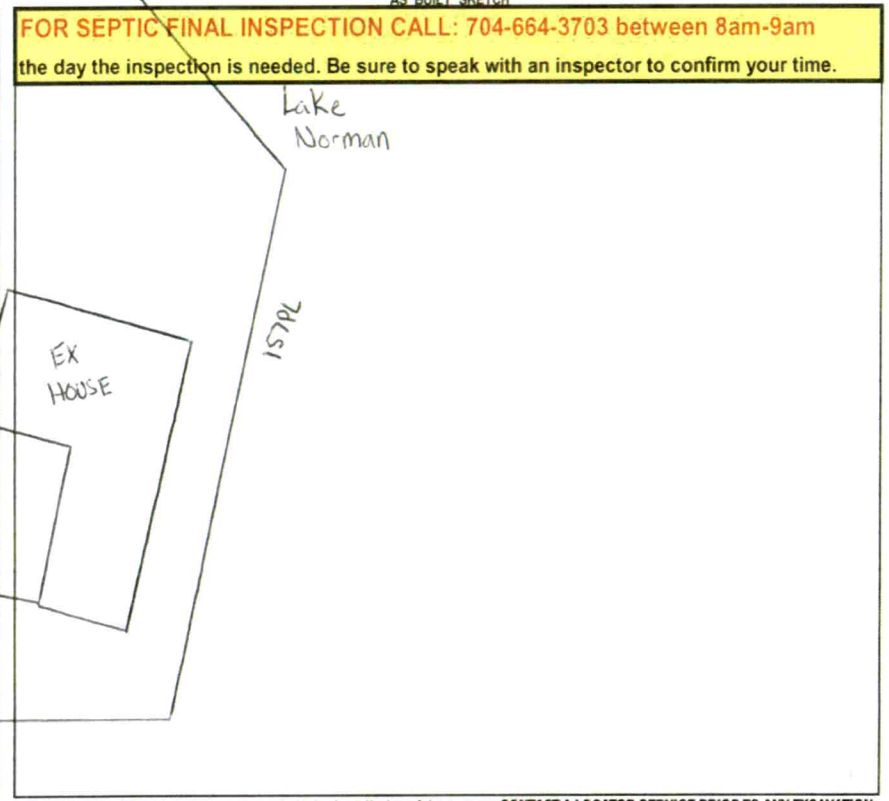

FOR SEPTIC FINAL INSPECTION CALL: 704-664-3703 between 8am-9am the day the inspection is needed. Be sure to speak with an inspector to confirm your time.

Permit can be suspended or revoked if any false information is supplied toward securing the permit / any unauthorized changes are made to the site / any unauthorized changes are made in the installation of the system. **CONTACT A LOCATOR SERVICE PRIOR TO ANY EXCAVATION**


☐ **IMPROVEMENT PERMIT** ***with plat*** *valid without expiration.* ☒ **IMPROVEMENT PERMIT** ***with site plan*** *valid for 60 mos.* ☒ **AUTHORIZATION TO CONSTRUCT** *valid for period equal to IMPROVEMENT PERMIT--not to exceed 60 mo.*

Owner / Applicant Signature: Date: Installed by: Lentz Workweiler

IMPROVEMENT PERMIT by: Cory Whit Date: 2/14/23 OPERATION PERMIT by: Matt Wi Date: 4/27/23

AUTHORIZATION TO CONSTRUCT by: Cory Whit Date: 2/14/23 Existing System Inspected by: Date:

FOR SEPTIC FINAL INSPECTION: CALL 704-664-3703 between 8am-9am the day the inspection is needed.

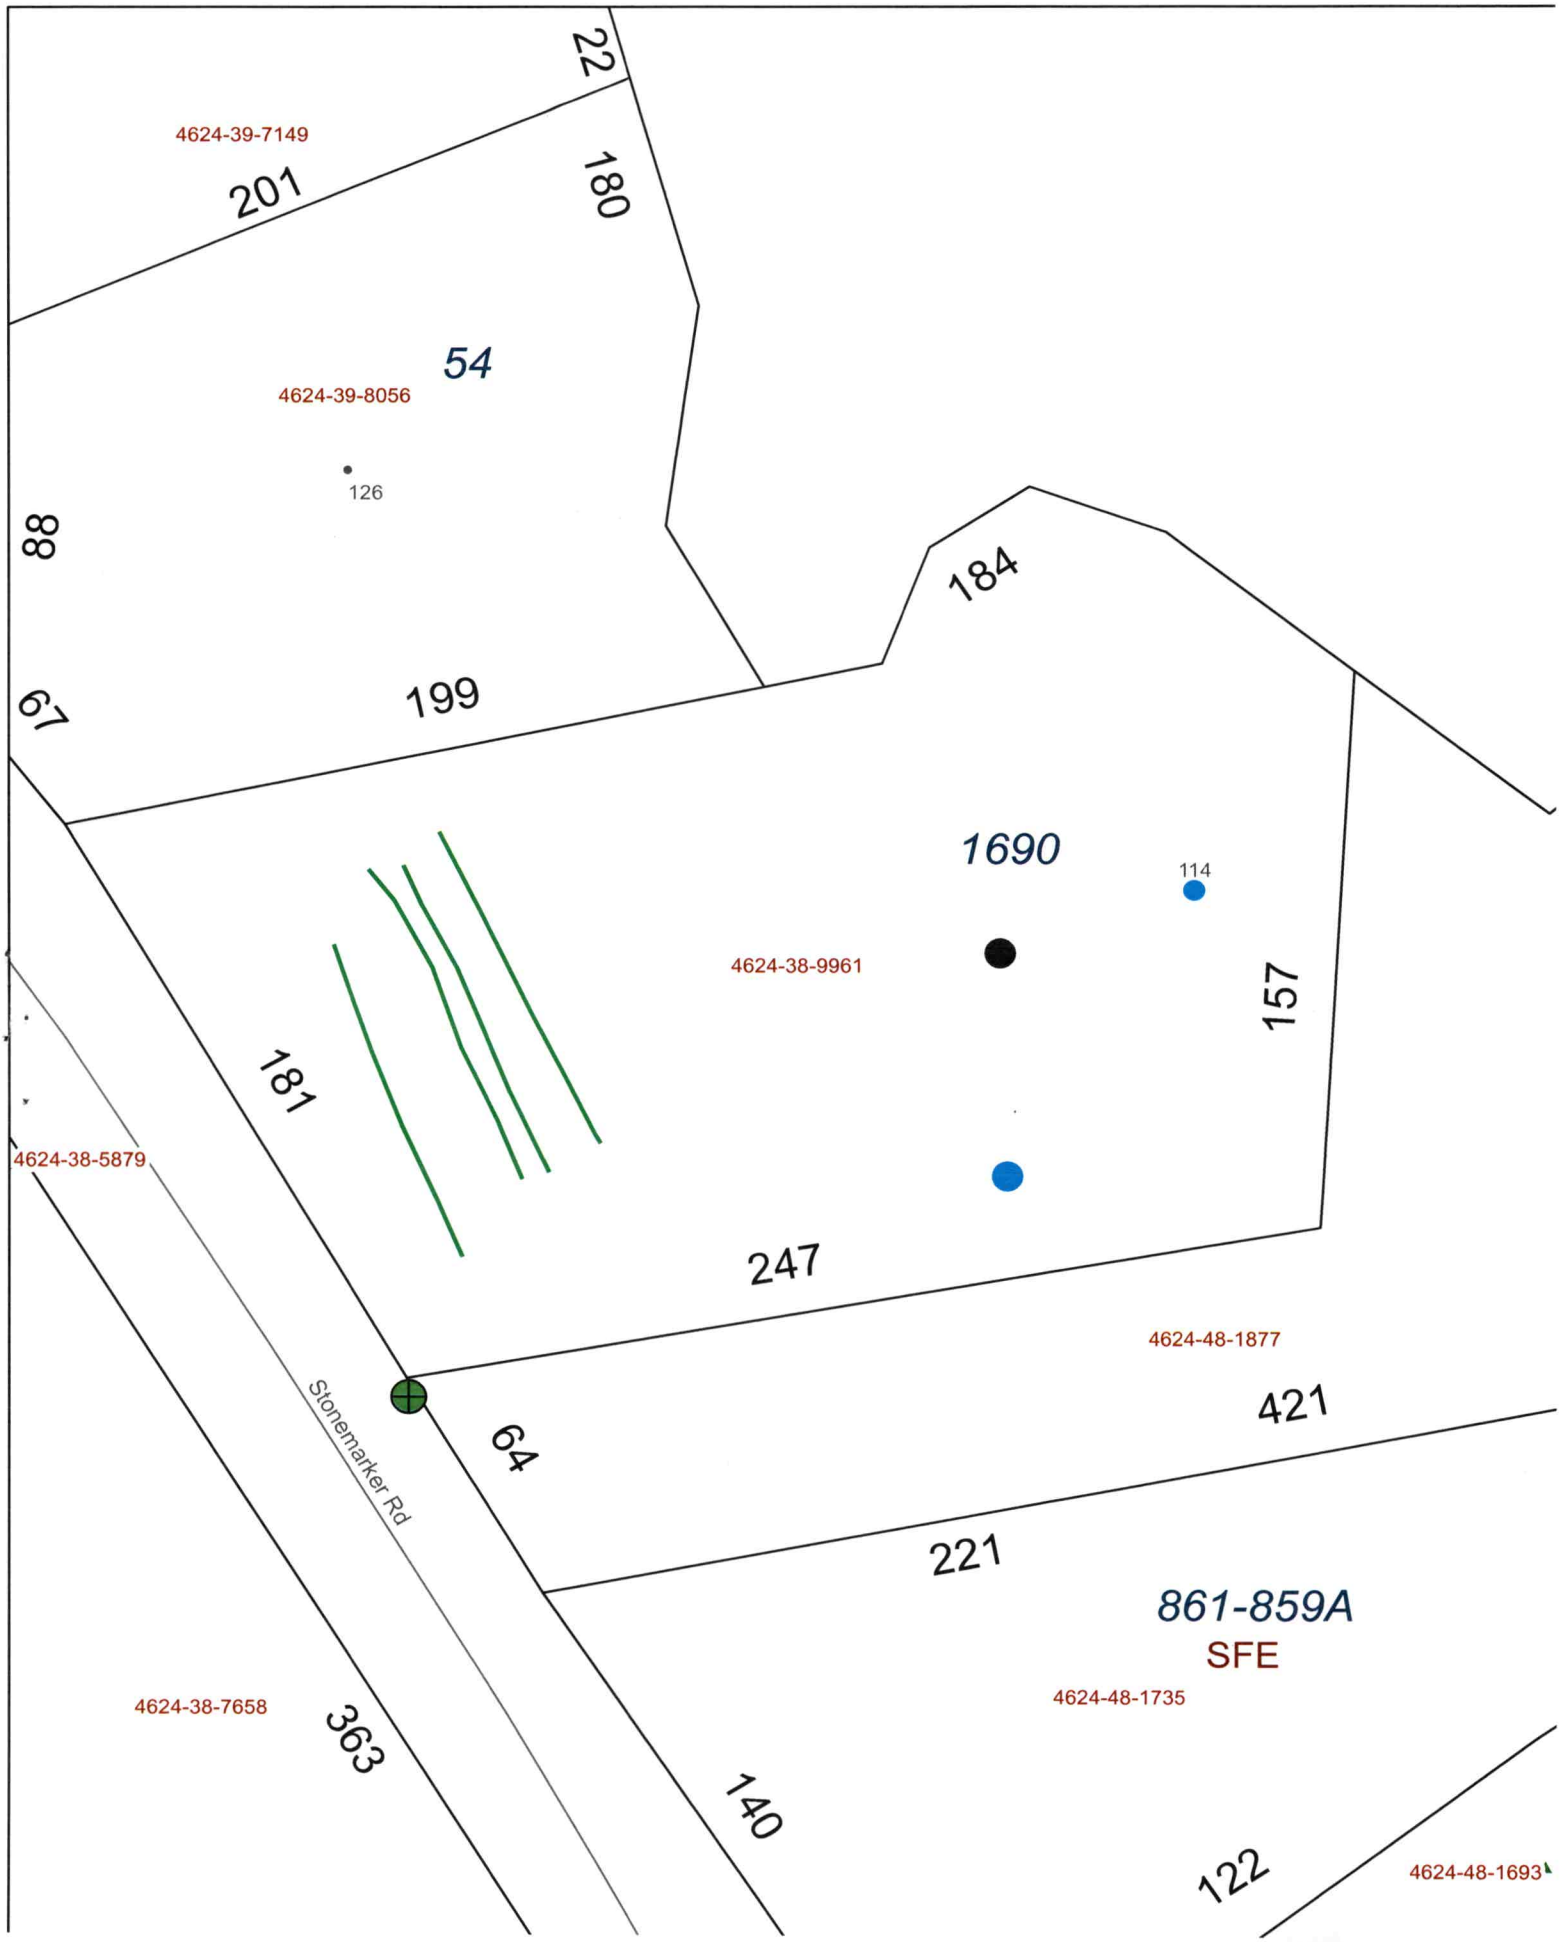
22
4624-39-7149
201
180
54
4624-39-8056
126
88
184
67
199
1690
114
4624-38-9961
157
181
4624-38-5879
247
4624-48-1877
421
Stonemarker Rd
64
221
861-859A
SFE
4624-48-1735
4624-38-7658
363
140
122
4624-48-1693

Lentz

IREDELL COUNTY HEALTH DEPARTMENT

STATESVILLE 704-878-5305 COPY MOORESVILLE 704-664-5281

IMPROVEMENT PERMIT / AUTHORIZATION TO CONSTRUCT / OPERATION PERMIT / EXISTING SYSTEM INSPECTION

PERMIT# 117116 PIN# 4624 38 9961 DATE 11/24/03

OWNER OR CONTRACTOR Lisa + Penny Reed PHONE: Business 704-201-4751 Home

ADDRESS 114 Stonemarker Rd. Mooresville, NC. 28117

LOCATION 1100 TR Stonemarker Rd. TR / ST Paved driveway

SUBDIVISION CL+T BLOCK / SECTION 6 LOT 1690 LOT AREA ~ 1.2 AC SITE CLASS. PS DESIGN FLOW 100 L.T.A.R.

Septic Tank: EXISTING Gallons: STB Date

Pump Tank: EXISTING Gallons: PT Date

Pump Make: Model Serial No.

Nitrification Field: No Fields Square Feet EXISTING Linear Feet SYSTEM

No Lines Trench Width Max Trench Bottom Depth Gravel Depth

☐ New System ☐ Repair System Type: I, II, III, IV, V, VI

System Description: EXISTING

Repair System Description:

Maintenance Agreement Required: ☐ Yes ☐ No

☐ House/Mod. Home No. Bedrooms

☐ Mobile Home No. Bathrooms

☐ Business No. Employees

☒ Other 2-3 Bay Garage

☐ Slab ☐ Crawl Space ☐ Basement w/plumbing ☐ Basement wo/plumbing

Water Supply: ☒ Individual ☐ Public ☐ Community

Comments:/Conditions:

Comments:/Conditions:

INITIAL SITE SKETCH

ICHD-Environmental Health Division

The proposed / ~~existing~~ Garage Addition addition does not appear to impact the existing septic system.


**NOTE: shall be min. 25' to well

Andy Melville R.S.

Date: 6-15-12

ICHD-Environmental Health Division

AS BUILT SKETCH

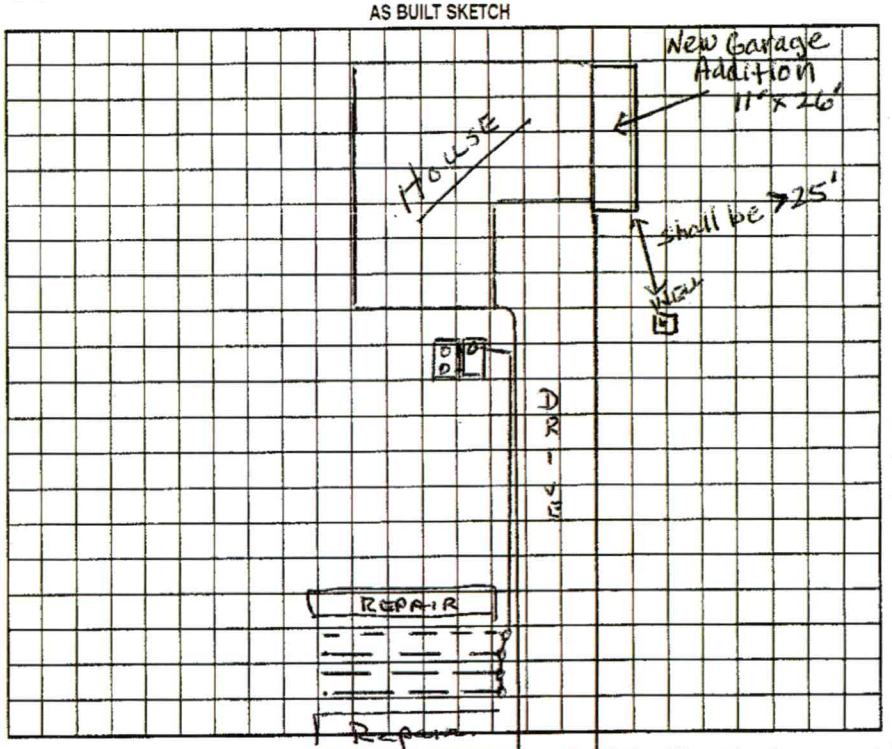

Permit can be suspended or revoked if any false information is supplied toward securing the permit/any unauthorized changes are made to the site/any unauthorized changes are made in the installation of the system. Improvement Permit with plat valid without expiration. Improvement Permit with site plan valid for sixty months. Authorization to Construct is valid for a period equal to that of Improvement Permit – not to exceed sixty months.

R/D

STONEMARKER RD.

Signed: [signature] date 11/24/03

Improvement Permit by: date

Authorization to Construct by: date

Installed by:

Operation Permit by: Wesley Sparks R.S. date 11/24/03

Existing System Inspection by: date

HEALTH DEPT. COPY: WHITE OWNER COPY (FINAL): YELLOW OWNER COPY (INITIAL): PINK