IREDELL COUNTY HEALTH DEPARTMENT

STATESVILLE 704-878-5305 COPY MOORESVILLE 704-664-5281

IMPROVEMENT PERMIT / AUTHORIZATION TO CONSTRUCT / OPERATION PERMIT / EXISTING SYSTEM INSPECTION

PERMIT# 117116 PIN# 4624 38 9961 DATE 11/24/03

OWNER OR CONTRACTOR Lisa + Perry Reed PHONE: Business 704-201-4751 Home

ADDRESS 114 Stonemarker Rd. Mooresville, NC. 28117

LOCATION 1100 TR Stonemarker Rd. TR/SE pond driveway

SUBDIVISION CL+T BLOCK / SECTION 6 LOT 1690 LOT AREA ~ 1.2 AC SITE CLASS. PS DESIGN FLOW 100 L.T.A.R.

Septic Tank: EXISTING Gallons; STB Date

Pump Tank: EXISTING Gallons; PT Date

Pump Make: Model Serial No.

Nitrification Field: No Fields Square Feet EXISTING Linear Feet ~~ST~~ STEM

No Lines Trench Width Max Trench Bottom Depth Gravel Depth

☐ New System ☐ Repair System Type: I, II, III, IV, V, VI

System Description: EXISTING

Repair System Description:

Maintenance Agreement Required: ☐ Yes ☐ No

☐ House/Mod. Home No. Bedrooms

☐ Mobile Home No. Bathrooms

☐ Business No. Employees

☒ Other 2-3 Bay Garage

☐ Slab ☐ Crawl Space ☐ Basement w/plumbing ☐ Basement wo/plumbing

Water Supply: ☒ Individual ☐ Public ☐ Community

Comments:/Conditions:

Comments:/Conditions:

INITIAL SITE SKETCH

ICHD-Environmental Health Divis...

The proposed / ~~existing~~ Garage Addition addition does not appear to impact the existing septic system.


**NOTE: shall be min. 25' to well

Andy Melville R.S.

Date: 6-15-12

ICHD-Environmental Health Division

AS BUILT SKETCH

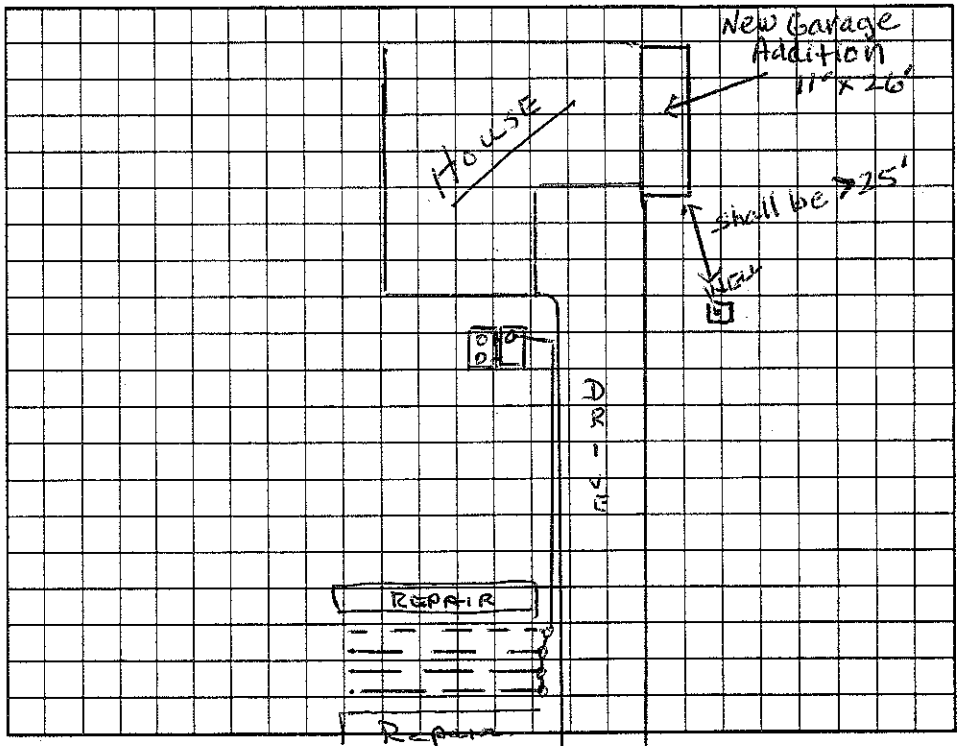

Permit can be suspended or revoked if any false information is supplied toward securing the permit/any unauthorized changes are made to the site/any unauthorized changes are made in the installation of the system. Improvement Permit with plat valid without expiration. Improvement Permit with site plan valid for sixty months. Authorization to Construct is valid for a period equal to that of Improvement Permit – not to exceed sixty months.

R/W

STONEMARKER RD.

Signed: [signature] date 11/24/03

Improvement Permit by: date

Authorization to Construct by: date

Installed by:

Operation Permit by: Wesley Sparks R.S. date 11/24/03

Existing System Inspection by: date

HEALTH DEPT. COPY: WHITE OWNER COPY (FINAL): YELLOW OWNER COPY (INITIAL): PINK