DELL COUNTY HEALTH DEPARTMENT

STATESVILLE 704-878-5305 MOORESVILLE 704-664-5281

IMPROVEMENT PERMIT / CERTIFICATE OF COMPLETION / OPERATION PERMIT / EXISTING SYSTEM INSPECTION

PROPERTY DESCRIPTION NO. 26403 DATE 4/25/97 TAX MAP NO. 4634398051 Watershed: X Yes ☐ No LW STVC

OWNER OR CONTRACTOR Charles Moser PHONE: Business ~~Home~~ WK (704) 372-4832

ADDRESS 4233 Hidden Brook Dr. Charlotte, NC 28205

LOCATION 126 Stone marker Ln

SUBDIVISION Clay BLOCK / SECTION 6 LOT 54 LOT AREA ____ SITE CLASS. ____ DESIGN FLOW ____ L.T.A.R. ____

Septic Tank: 1000 Gallons; STB ____ Date ____

Pump Tank: ____ Gallons; PT ____ Date ____

Pump Make: EXISTING Model ____ Serial No. ____

Nitrification Field: No Fields ____ Square Feet ____ Linear Feet ____

No Lines ____ Trench Width ____ Max Trench Bottom Depth ____ Gravel Depth ____

☐ New System ☐ Repair System Type: I (II) III, IV, V, VI

System Description: Existing System

Repair System Description: ____

Maintenance Agreement Required: ☐ Yes ☒ No

☐ House/Mod. Home No. Bedrooms 3

☒ Mobile Home No. Bathrooms 2

☐ Business No. Employees ____

☐ Other ____


☐ Slab ☐ Crawl Space ☐ Basement w/plumbing ☐ Basement wo/plumbing

Water Supply: ☒ Individual ☐ Community ☐ Public

Comments: Existing System appears to be operating fine at time of inspection. Okay for 3 bedrooms Home.

Comments: * System/Home is only being used on weekends & holidays

INITIAL SITE SKETCH Not to Scale

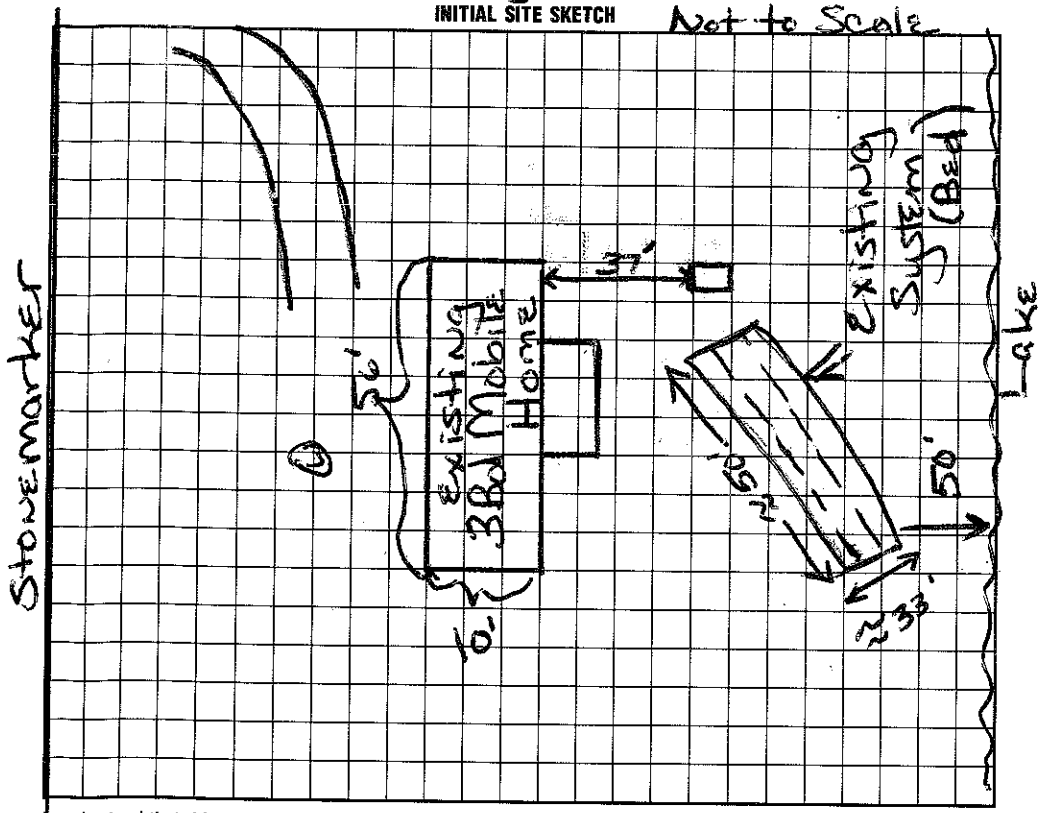

AS BUILT SKETCH

I understand that this permit can be suspended or revoked if any false information is supplied toward securing the permit/any unauthorized changes are made to the site/any unauthorized changes are made in the installation of the system. Improvement Permit is valid for 60 months from date of issuance.

Signed: Charles Moser

Improvement Permit by: ____ date ____

Existing System Inspection by: Maria Watson date 4/25/97

Installed by: ____

Certificate of Completion by: ____ date ____

Operation Permit by: ____ date ____

HEALTH DEPT. COPY: WHITE INSPECTION COPY (FINAL): GREEN OWNER COPY (FINAL): YELLOW INSPECTION COPY (INITIAL): PINK OWNER COPY (INITIAL): GOLD