DELL COUNTY HEALTH DEPARTMENT

STATESVILLE 704-878-5305 — MOORESVILLE 704-664-5281

4624398056

PROVEMENT PERMIT / CERTIFICATE OF COMPLETION / OPERATION PERMIT / EXISTING SYSTEM INSPECTION

PROPERTY DESCRIPTION NO. 26403 DATE 4/25/97 TAX MAP NO. 4634398051 Watershed: X Yes ☐ No W.S. IV-C

OWNER OR CONTRACTOR Charles Moser PHONE: Business ____ Home WK (704) 372-4832

ADDRESS 4233 Hidden Brook Dr. Charlotte, NC 28205

LOCATION 126 Stone Marker Ln

SUBDIVISION ____ BLOCK / SECTION 6 LOT 54 LOT AREA ____ SITE CLASS. ____ DESIGN FLOW ____ L.T.A.R. ____

Septic Tank: 1000 Gallons; STB ____ Date ____

Pump Tank: ____ Gallons; PT ____ Date ____

Pump Make: Existing Model ____ Serial No. ____

Nitrification Field: No Fields ____ Square Feet ____ Linear Feet ____

No Lines ____ Trench Width ____ Max Trench Bottom Depth ____ Gravel Depth ____

☐ New System ☐ Repair System Type: I, (II), III, IV, V, VI

System Description: Existing System

Repair System Description: ____

Maintenance Agreement Required: ☐ Yes X No

☐ House/Mod. Home No. Bedrooms 3

X Mobile Home No. Bathrooms 2

☐ Business No. Employees ____

☐ Other ____


☐ Slab ☐ Crawl Space ☐ Basement w/plumbing ☐ Basement wo/plumbing

Water Supply: X Individual ☐ Community ☐ Public

Comments: Existing System appears to be operating fine at time of inspection) Okay for 3 bedrooms Home.

Comments: * System/Home is only being used on weekends & holidays

INITIAL SITE SKETCH Not to Scale

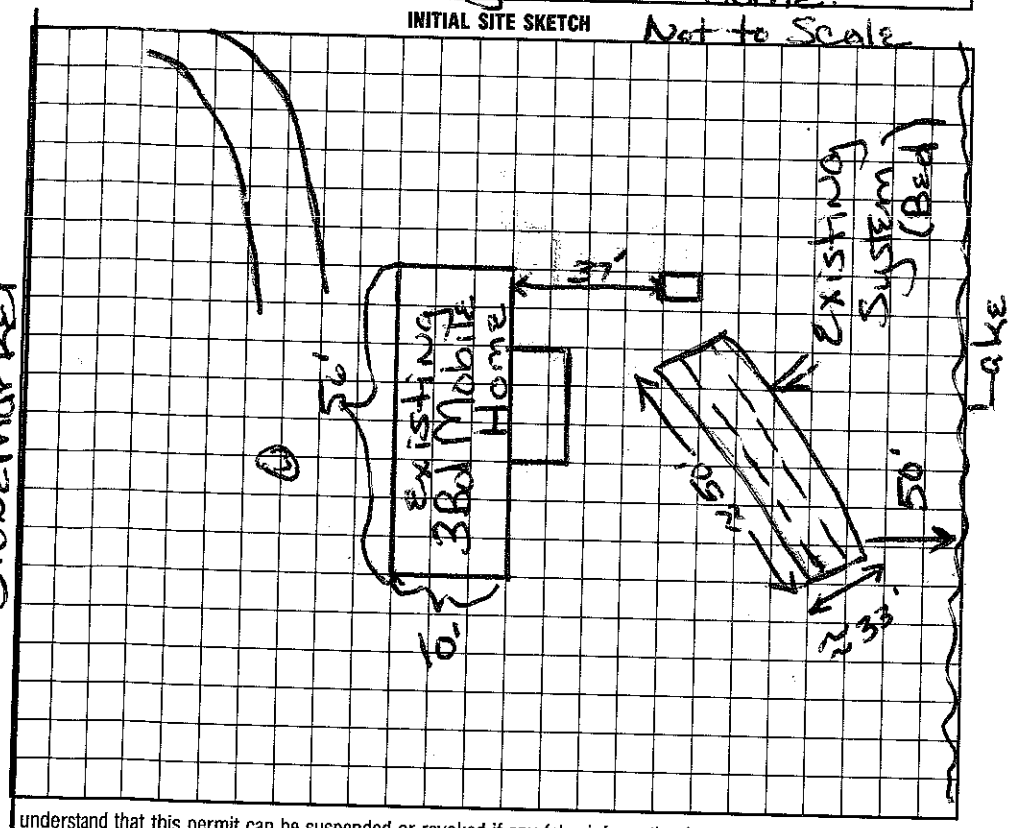

AS BUILT SKETCH

I understand that this permit can be suspended or revoked if any false information is supplied toward securing the permit/any unauthorized changes are made to the site/any unauthorized changes are made in the installation of the system. Improvement Permit is valid for 60 months from date of issuance.

Signed: Charles Moser

Improvement Permit by: ____ date ____

Existing System Inspection by: Maria Watson date 4/25/97

Installed by: ____

Certificate of Completion by: ____ date ____

Operation Permit by: ____ date ____

HEALTH DEPT. COPY: WHITE INSPECTION COPY (FINAL): GREEN OWNER COPY (FINAL): YELLOW INSPECTION COPY (INITIAL): PINK OWNER COPY (INITIAL): GOLD