IREDELL COUNTY HEALTH DEPARTMENT

STATESVILLE 704-878-5305 $375 MOORESVILLE 704-664-5281 11:30

IMPROVEMENT PERMIT / AUTHORIZATION TO CONSTRUCT / OPERATION PERMIT / EXISTING SYSTEM INSPECTION

PERMIT# 117121 PIN# 4624 43 0740 704 660-5429 DATE 12/15/03

OWNER OR CONTRACTOR Zande Homes c/o ~~DAVE BARBIND~~ ~~704-873-2191~~ Home

ADDRESS 6520 S HARLET OAK LN. CHARLOTTE, NC 28226 107 N Main St. Mooresville NC

LOCATION Wesham Rd. / 1100 ft Wesham Rd on R

SUBDIVISION SOUTHPOINTE BLOCK / SECTION LOT 5 LOT AREA .69 SITE CLASS. P3 DESIGN FLOW 480 L.T.A.R. .3

Septic Tank: 1000 Gallons; STB 312 Date 11-27-07

Pump Tank: 1000 Gallons; PT 283 Date 1-19-08

Pump Make: Goulds Model WE0512M Serial No.

Nitrification Field: No Fields 1 Square Feet 534/801 Linear Feet 267

No Lines 4 Trench Width 2-3 Max Trench Bottom Depth 3 Gravel Depth NA

[X] New System [ ] Repair System Type: I, II, III, IV, V, VI

System Description: Res Dual - 16" PPBPS

Repair System Description: Same

Maintenance Agreement Required: [X] Yes [ ] No

[X] House/Mod. Home No. Bedrooms 4

[ ] Mobile Home No. Bathrooms 3

[ ] Business No. Employees

[ ] Other

[ ] Slab [X] Crawl Space [ ] Basement w/plumbing [ ] Basement wo/plumbing

Water Supply: [X] Individual [ ] Public [ ] Community

Comments:/Conditions: Very Tight - System is Sand mounded already - Night to no room for modification to this plan.


Comments:/Conditions: 11/1/07 House plans essentially will fit within set backs without changing drainfield or repair.

2/29/08 Checked Tanks AC.

3/3/08 Checked lines 40 LF


INITIAL SITE SKETCH

1" = 60'

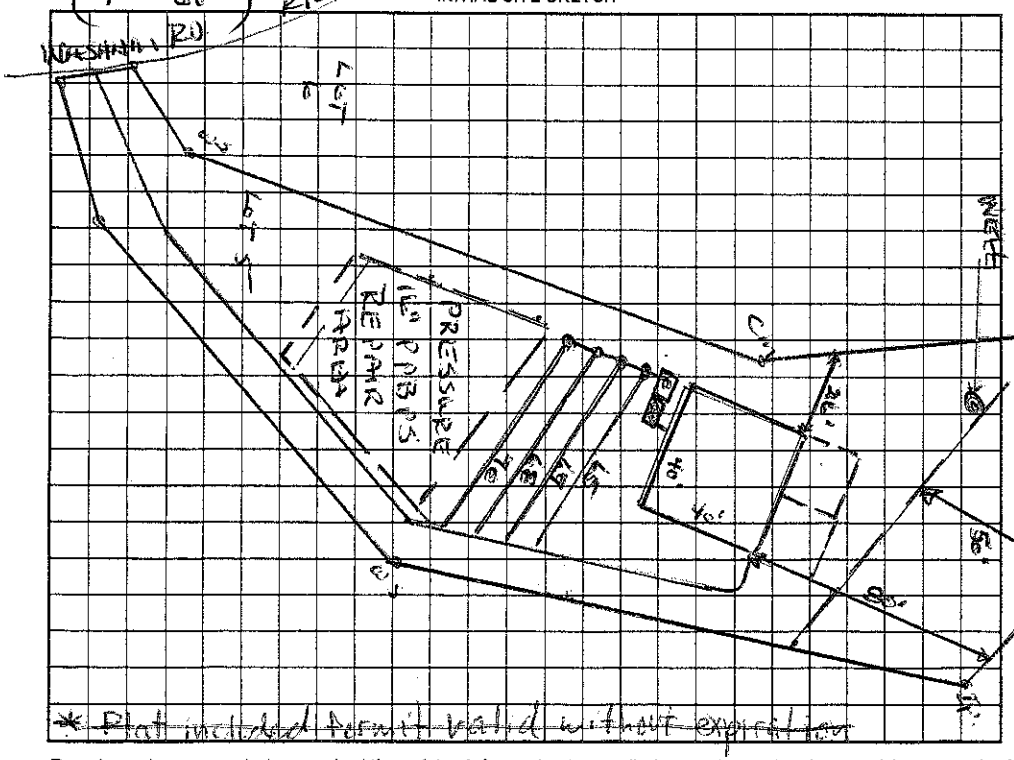

AS BUILT SKETCH

5/20/08 Set 2HP pressure head/elect @ alarm

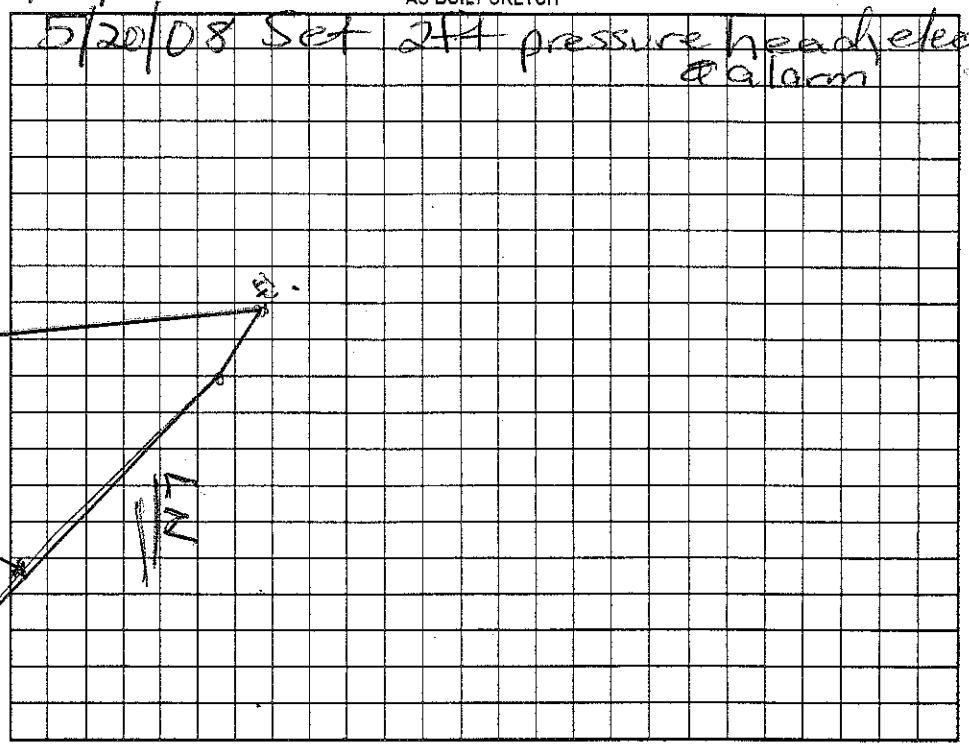

* Plat included Permit valid without expiration

Permit can be suspended or revoked if any false information is supplied toward securing the permit/any unauthorized changes are made to the site/any unauthorized changes are made in the installation of the system. Improvement Permit with plat valid without expiration, Improvement Permit with site plan valid for sixty months. Authorization to Construct is valid for a period equal to that of Improvement Permit – not to exceed sixty months.

Signed: X [signature] date

Improvement Permit by: [signature] RS date 12/16/03

Authorization to Construct by: Anthony Cohen date 11/1/07

Installed by:

Operation Permit by: [signature] RS date 5/21/08

Existing System Inspection by: date

HEALTH DEPT. COPY: WHITE OWNER COPY (FINAL): YELLOW OWNER COPY (INITIAL): PINK