IREDELL COUNTY HEALTH DEPARTMENT

STATESVILLE 704-878-5305 MOORESVILLE 704-664-5281

IMPROVEMENT PERMIT / AUTHORIZATION TO CONSTRUCT / OPERATION PERMIT / EXISTING SYSTEM INSPECTION

100.00 Paid

PERMIT# 117084 PIN# 4624-43-1758 DATE 11/1/05

OWNER OR APPLICANT Goodwin Bldr. PHONE: Business 7044008515 Home 7044839386

ADDRESS 4277 Apex Dr. Maiden NC 28650

LOCATION BSR, TL 2nd Washam, on Rt in Curve

SUBDIVISION South Point BLOCK / SECTION ____ LOT 6 LOT AREA 0.77 Ac SITE CLASS. PS DESIGN FLOW 360 L.T.A.R. 0.3

Septic Tank: 1000 Gallons: STB 825 Date 4-4-06

Pump Tank: 1060 Gallons: PT 302 Date 4-5-06

Pump Make: Zoeller Model ____ Serial No. ____

Nitrification Field: No Fields 1 Square Feet 600 eq Linear Feet 200

No Lines 4 Trench Width 24"&36" Max Trench Bottom Depth 36" Gravel Depth — ☐ Gravity ☒ Pressure

☒ New System ☐ Repair ☐ Expansion System Type: I II III (IV) V VI

System Description: LP Panel Block

Repair System Description: Same

Maintenance Agreement Required: ☒ Yes ☐ No

☒ House/Mod. Home No. Bedrooms 3

☐ Mobile Home No. Persons ____

☐ Business No. Employees ____

☐ Other ____

Water Supply: ☒ Individual ☐ Public ☐ Community


☐ Slab ☐ Crawl Space ☐ Basement w/plumbing ☐ Basement wo/plumbing

Comments:/Conditions: 36" 9 Foc


1"=40'

Comments:/Conditions:

INITIAL SITE SKETCH

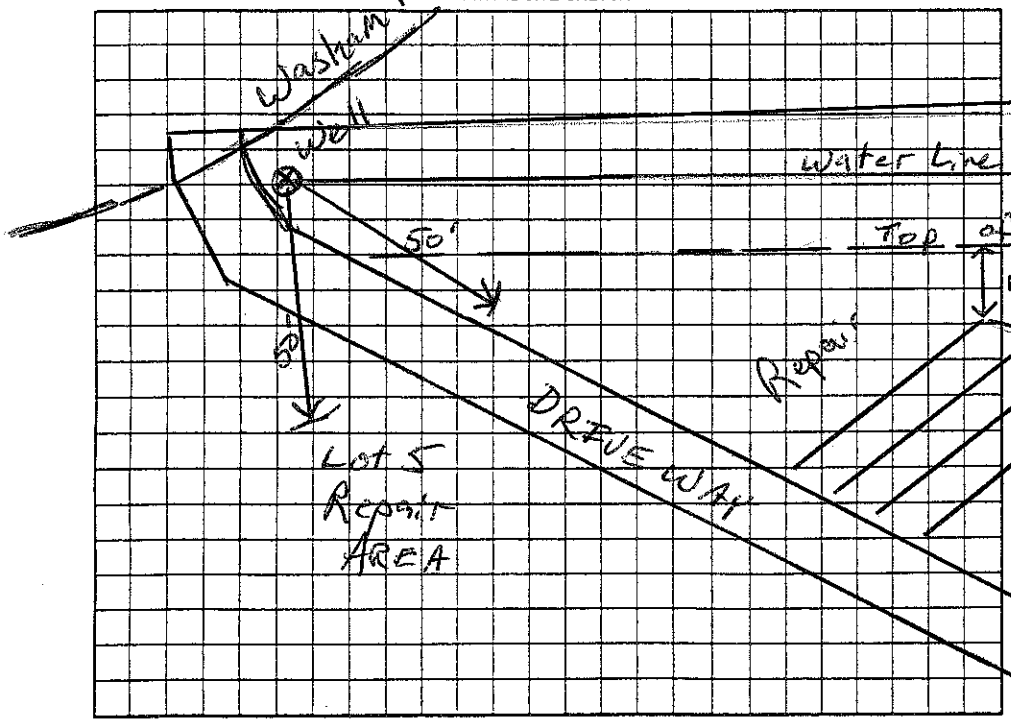

AS BUILT SKETCH

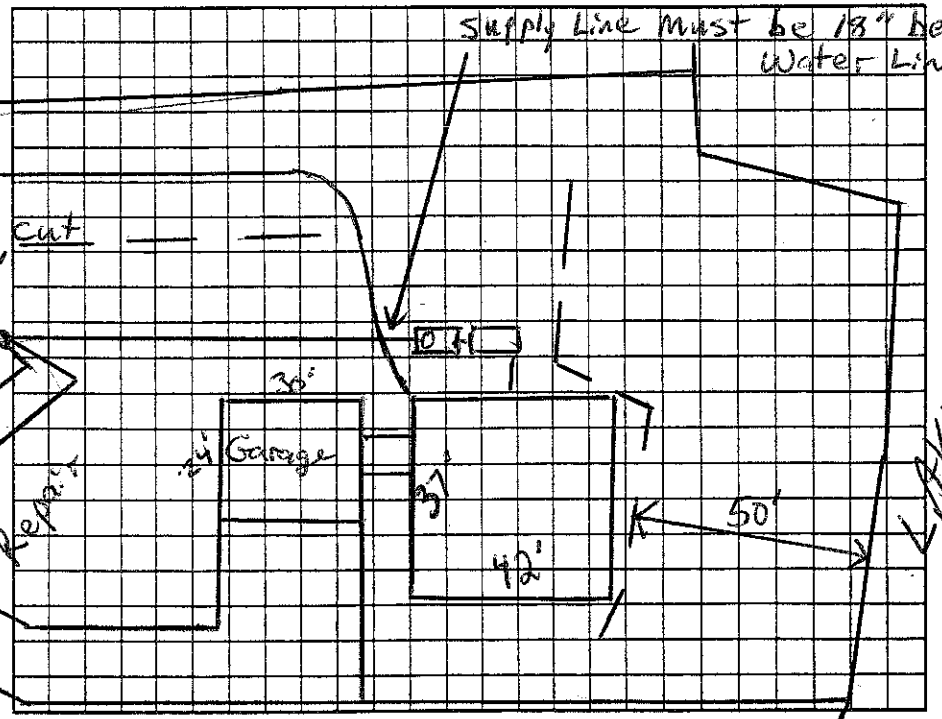

Permit can be suspended or revoked if any false information is supplied toward securing the permit/any unauthorized changes are made to the site/any unauthorized changes are made in the installation of the system. Improvement Permit with plat valid without expiration ☐ Improvement Permit with site plan valid for sixty months ☒ Authorization to Construct is valid for a period equal to that of Improvement Permit – not to exceed sixty months.

Signed: ____ date 11/02/05 Installed by: Rowan Septic

Improvement Permit by: RS date 11/1/05 Operation Permit by: RS date 5/3/06

Authorization to Construct by: RS date 11/1/05 Existing System Inspection by: ____ date ____

HEALTH DEPT COPY: WHITE OWNER COPY (FINAL): YELLOW OWNER COPY (INITIAL): PINK