IREDELL COUNTY HEALTH DEPARTMENT

STATESVILLE 704-878-5305 MOORESVILLE 704-664-5281

IMPROVEMENT PERMIT / AUTHORIZATION TO CONSTRUCT / OPERATION PERMIT / EXISTING SYSTEM INSPECTION

PERMIT # 108695 PIN # 4624 44 1233 DATE 4-20-2009

OWNER or APPLICANT Ron Carroll PHONE: Business/Fax 704 658-1449 Home: 704 658 1404

OWNER or APPLICANT ADDRESS P.O. Box 4297 Mooresville, NC

LOCATION / DIRECTIONS Brawley School Rd TL on Washam Rd lot is on left. #171

SUBDIVISION Clet BLOCK / SECTION 6 LOT # 17.38 LOT AREA 1.036 Acre DESIGN FLOW 480gpd L.T.A.R. .3

Septic Tank 1000 Gallons: STB 528 Date 4-4-08 ☒ New System ☐ Repair ☐ Expansion System Type I II III (IV) V VI

Pump Tank 1000 Gallons: PT 17 Date 4-7-08 System Description: Pump-LP- Panel Blk.

Pump Make Goulds Model WE0512HH1U Serial # M086531? Repair System Description: Same

Nitrification Field No Fields 1 No Lines 4 Linear Feet 260' Maintenance Agreement Required ☒ YES ☐ NO

Trench Width Min. 24" Max. Trench Bottom Depth 30" Gravel Depth N/A ☐ GRAVITY ☒ PRESSURE


☒ Residence No. Bedrooms 4 ☐ Business No. Persons ☐ Other No. Employees ☐ Slab ☐ Crawl Space ☐ Basement w/plumbing ☐ Basement w/o plumbing

Water Supply: ☒ Private ☐ Public ☐ Community


Comments / Conditions Note: Keep Septic System at least 10ft From PL & 50ft From any well. Divert stormwater from Culvert to property line. Scale 1:50

Comments / Conditions Bury Supply line at least 30 inches under driveway. Must keep vehicular traffic off Septic system. Use In line filter on PT

INITIAL SITE SKETCH

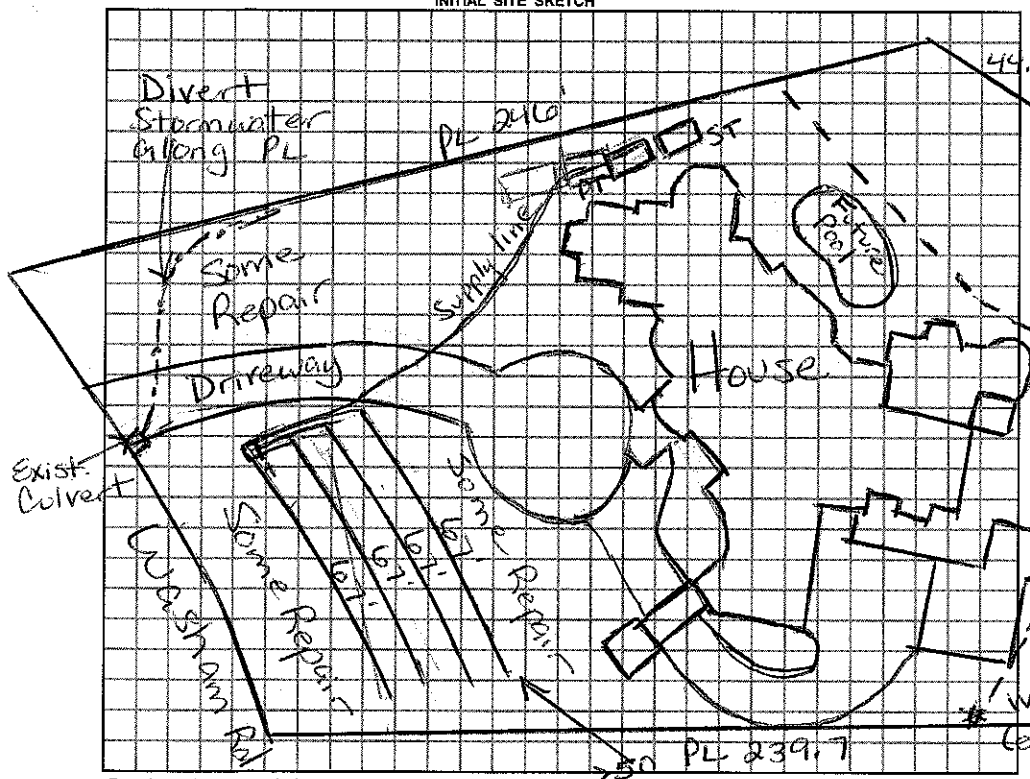

AS BUILT SKETCH

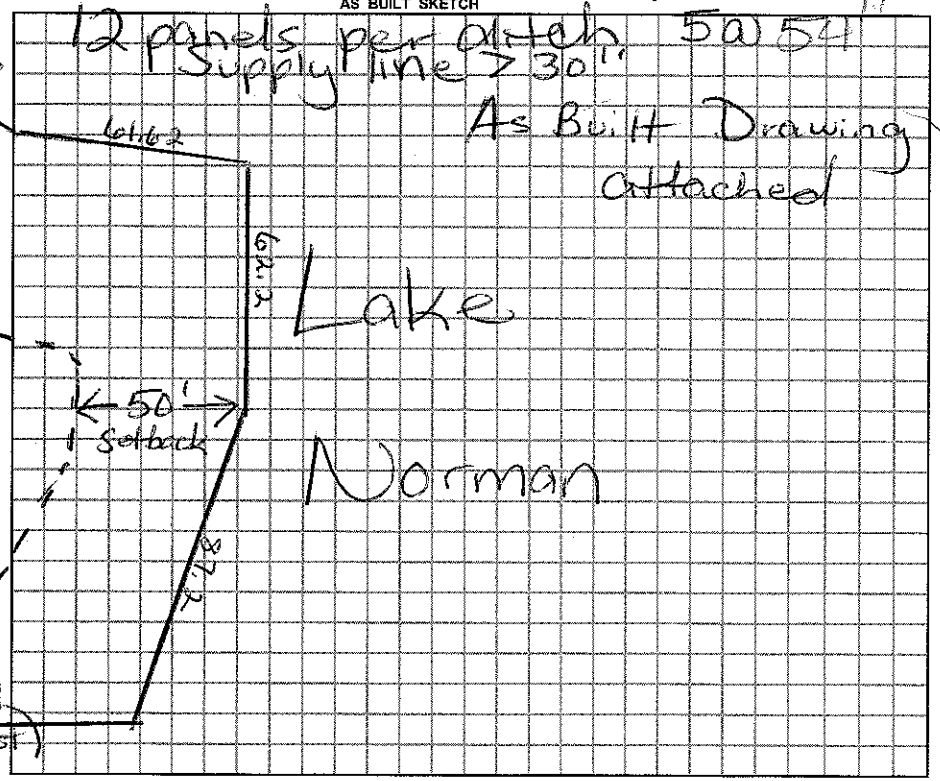

Permit can be suspended or revoked if any false information is supplied toward securing the permit / any unauthorized changes are made to the site / any unauthorized changes are made in the installation of the system.

☐ *IMPROVEMENT PERMIT w / plat valid without expiration.* ☐ *IMPROVEMENT PERMIT w / site plan valid for 60 mos.* ☐ *AUTHORIZATION TO CONSTRUCT valid for period equal to IMPROVEMENT PERMIT-not to exceed 60 mo.*

Owner / Applicant Signature: Date 4-22-09

Improvement Permit by: Date 4/20/09

Authorization to Construct by: Date 4/20/09

Installed by: Steve Jordan RS

Operation Permit by: Date: 6/12/09

Existing System Inspected by: Date:

YOU SHOULD CONTACT A LOCATOR SERVICE PRIOR TO ANY EXCAVATION.

WHITE COPY Environmental Health YELLOW COPY (Final) Owner / Applicant PINK COPY (Initial) Owner / Applicant