# IREDELL COUNTY HEALTH DEPARTMENT

Statesville Office (704) 878-5305 Mooresville Office (704) 660-3625 PERMIT # 176087

## IMPROVEMENT PERMIT / AUTHORIZATION TO CONSTRUCT / OPERATION PERMIT / EXISTING SYSTEM

PIN # 4624471623

APPLICANT: BILLY MILLER APPLICANT ADDRESS: 144 GREYFRIARS MOORESVILLE NC 28117

SITE ADDRESS: 144 GREYFRIARS PHONE: ALT. PHONE:


SITE DIRECTIONS: BRAWLEY SCHOOL - TL GREYFRIARS - ON RT.

SUBDIVISION: CL+T SECTION: LOT # 525 LOT AREA: .71AC DESIGN FLOW: 480 L.T.A.R.: .3 gpd/ft²

| | | | | | | | | | |
|---|---|---|---|---|---|---|---|---|---|
| Septic Tank 1000 (gal) | STB 794 | Date 10-8-13 | ☑ New System ☐ Repair ☐ Expansion | System Type: I II (III) IV V VI | ☑ Residence | No. Bedrooms 4 | Water Supply |
| Pump Tank (gal) | PT | Date | System Description: GRAVITY CONVENTIONAL + PPBPS | | ☐ Business | No. Persons 8 | ☑ Private |
| Pump Make | Model | Serial # NEW | Repair System Description: LPPPBPS | | ☐ Other | No. Employees | ☐ Public |
| # Nitrification Fields 1 | # Lines 2 OLD + 3 NEW | Linear Ft: 135' | Maintenance Agreement Required: ☐ YES ☑ NO | | ☐ Slab | ☑ Crawl Space | ☐ Community |
| Trench Width 24" | Max. Trench Bottom Depth 36" | Gravel Depth N/A | ☑ GRAVITY ☐ PRESSURE | | ☐ Basement w/plumbing | ☐ Basement w/o plumbing | |

Comments / Conditions:

INITIAL SITE SKETCH

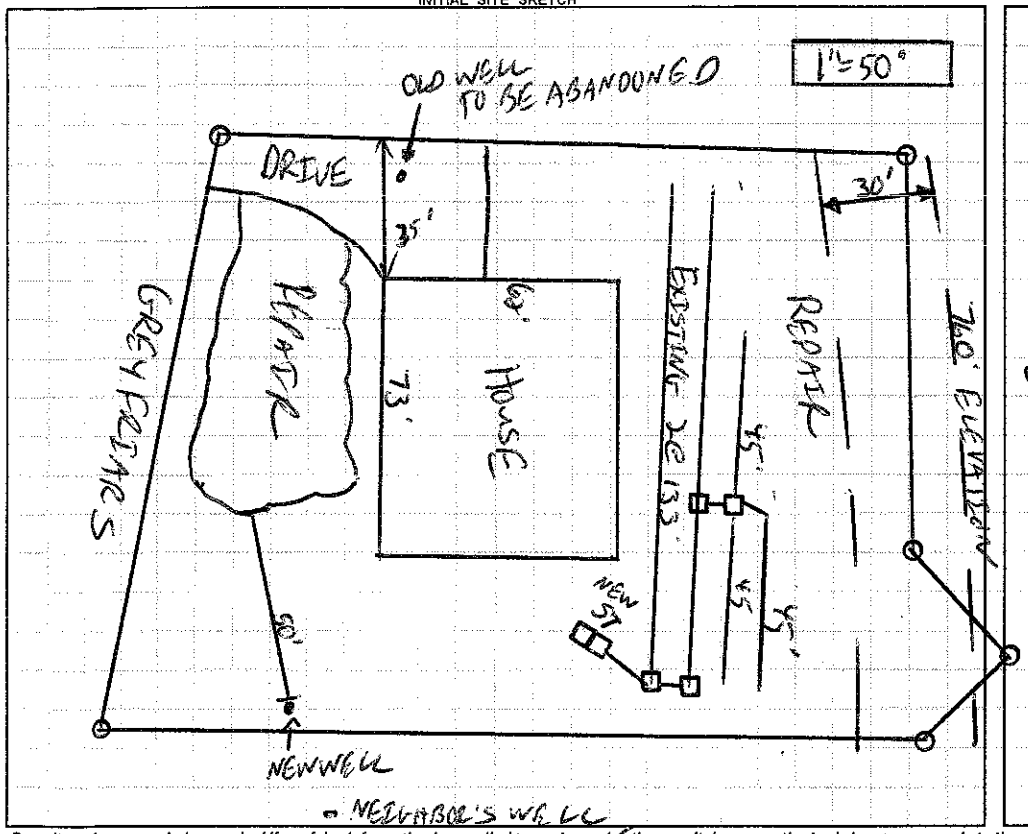


AS BUILT SKETCH

*Permit can be suspended or revoked if any false information is supplied toward securing the permit / any unauthorized changes are made to the site / any unauthorized changes are made in the installation of the system.* **CONTACT A LOCATOR SERVICE PRIOR TO ANY EXCAVATION**

☐ **IMPROVEMENT PERMIT** *with plat valid without expiration.* ☑ **IMPROVEMENT PERMIT** *with site plan valid for 60 mos.* ☑ **AUTHORIZATION TO CONSTRUCT** *valid for period equal to IMPROVEMENT PERMIT--not to exceed 60 mo.*

Owner / Applicant Signature: Date: 2/4/13 Installed by: ORBISON

IMPROVEMENT PERMIT by: C. Brady Freeman REHS Date: 1/31/13 OPERATION PERMIT by: Date: 11-14-13

AUTHORIZATION TO CONSTRUCT by: C. Brady Freeman Date: 1/31/13 Existing System Inspected by: Date:

Health Dept. Copy - WHITE Applicant (Final Approval) - YELLOW Applicant (Conditional Approval) - PINK