1130

IREDELL COUNTY HEALTH DEPARTMENT

STATESVILLE 704-878-5305 MOORESVILLE 704-664-5281

IMPROVEMENT PERMIT / AUTHORIZATION TO CONSTRUCT / OPERATION PERMIT / EXISTING SYSTEM INSPECTION

PERMIT# 104485 PIN# 4624 27 5705 .1104 4624-47-3878 DATE Jan 13, 03

OWNER OR CONTRACTOR Crescent Resources Inc // The Point on Norman Land Phone: Business 375-5999 Home

ADDRESS 2214 Brawley Sch Rd. Mooresville, N.C. 28117

LOCATION Brawley Sch Rd. TL Torrence Chapel Rd. on Right

SUBDIVISION The Point BLOCK/SECTION 11 LOT 1104 LOT AREA 53,563 sf± SITE CLASS PS DESIGN FLOW 480gpd L.T.A.R. .25-.3

Septic Tank: 1000 Gallons; STB 338 Date 3-3-06

Pump Tank: 1000 Gallons; PT 27 Date 9-7-05

Pump Make: Gould Model WE0312mV Serial No. C0677630

Nitrification Field: 2 @ 90' Fields 1 Square Feet 1320 Linear Feet 440

No Lines 4 @ 110' Trench Width 36" Max Trench Bottom Depth 36" Gravel Depth N/A

☑ New System ☐ Repair System Type: I, II, III, IV, V, VI

System Description: PM - 25% Reduction

Repair System Description: 4 pm 25 50% Reduction

Maintenance Agreement Required: ☐ Yes ☑ No

☑ House/Mod. Home ☐ Mobile Home ☐ Business ☐ Other

No. Bedrooms 4 No. Bathrooms 4 No. Employees

☐ Slab ☑ Crawl Space ☐ Basement w/plumbing ☐ Basement wo/plumbing


Water Supply: ☐ Individual ☑ Public ☐ Community

Comments/Conditions: REAR YARD NOT EVALUATED. 12/21/05 Reviewed Building Plans, Essentially in Compliance with Original Permit although repair will probably be 50% Reduction


Comments/Conditions: ☆ Do Not overcut house pad.

1" = 50'

INITIAL SITE SKETCH

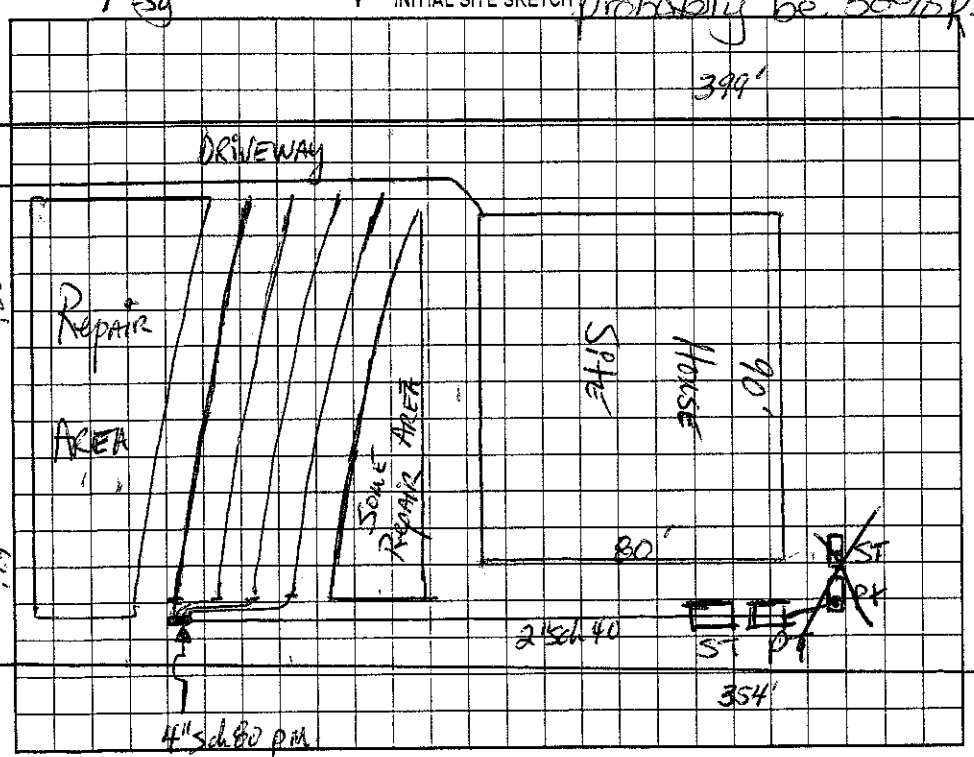

AS BUILT SKETCH

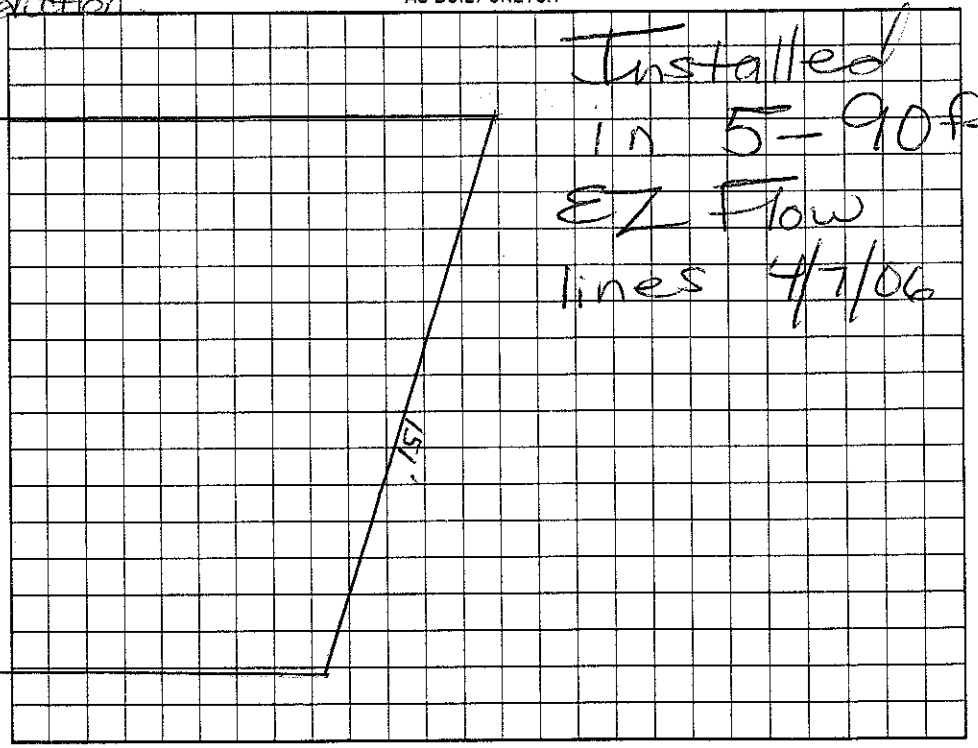

Permit can be suspended or revoked if any false information is supplied toward securing the permit/any unauthorized changes are made to the site/any unauthorized changes are made in the installation of the system. Improvement Permit with plat valid without expiration. Improvement Permit with site plan valid for sixty months. Authorization to Construct is valid for a period equal to that of Improvement Permit – not to exceed sixty months.

Signed: date 2/18/03 Installed by: Bobby Mayhew

Improvement Permit by: RS date Jan 13, 03 Operation Permit by: RS date 7/21/06

Authorization to Construct by: RS date 12/21/05 Existing System Inspection by: date

HEALTH DEPT. COPY: WHITE OWNER COPY (FINAL): YELLOW OWNER COPY (INITIAL): PINK