IREDELL COUNTY HEALTH DEPARTMENT

STATESVILLE 704-878-5305 MOORESVILLE 704-664-5281

1:30

IMPROVEMENT PERMIT / AUTHORIZATION TO CONSTRUCT / OPERATION PERMIT / EXISTING SYSTEM INSPECTION

PERMIT# 109489 PIN# 4624 27 5705 . 1106 Lot 4624475770 DATE Jan 13, 03

OWNER OR CONTRACTOR Crescent Resources Lux / The Point on Norman / HHZ PHONE: Business 375-5999 Home

ADDRESS 2214 Brawley Sch Rd. Mooresville NC 28117

LOCATION Brawley Sch Rd. TL Torrence Chapel Road 2nd on Right

SUBDIVISION The Point BLOCK/SECTION 11 LOT 1106 LOT AREA 55166 ft² SITE CLASS. 4S DESIGN FLOW 480 gpd L.T.A.R. .225 - .3

Septic Tank: 1000 Gallons; STB Date

Pump Tank: 1000 Gallons; PT Date

Pump Make: Model Serial No.

Nitrification Field: No Fields 1 Square Feet 1500 Linear Feet 500

No Lines 5@100 Trench Width 36" Max Trench Bottom Depth 36" Gravel Depth NA

☑ New System ☐ Repair System Type: I, II, III, IV, V, VI

System Description: Rm - 25% Reduction

Repair System Description: LP PBBR

Maintenance Agreement Required: ☐ Yes ☑ No

☐ House/Mod. Home No. Bedrooms 4/4

☐ Mobile Home No. Bathrooms

☐ Business No. Employees

☐ Other


☐ Slab ☑ Crawl Space ☐ Basement w/plumbing ☐ Basement wo/plumbing

Water Supply: ☐ Individual ☐ Public ☐ Community


Comments:/Conditions: Rear yard not evaluated.

Comments:/Conditions: Reviewed Building plans and site plans essentially in compliance with I.P. Installed 6 lines ~84' each Pressure, elect & alarm 6/13/05 MK

1"=50' INITIAL SITE SKETCH

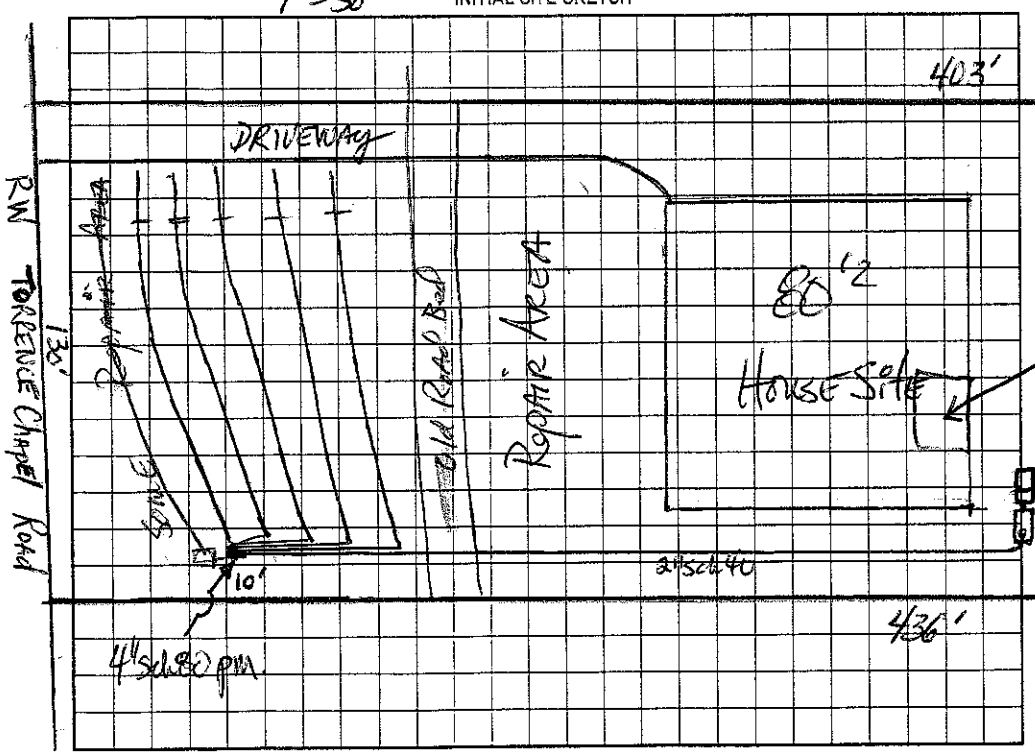

AS BUILT SKETCH

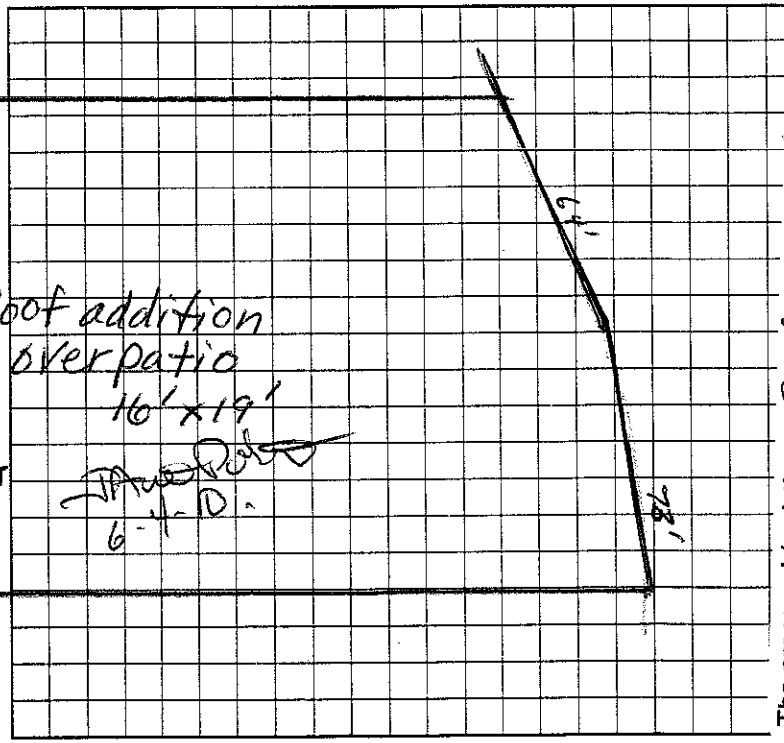

The proposed / ~~existing~~ Roof over patio addition does not appear to impact the existing septic system.

**NOTE:

Judy Mullinax REHS

Date: 6-14-05

ICHD-Environmental Health Division

Permit can be suspended or revoked if any false information is supplied toward securing the permit/any unauthorized changes are made to the site/any unauthorized changes are made in the installation of the system. Improvement Permit with plat valid without expiration. Improvement Permit with site plan valid for sixty months. Authorization to Construct is valid for a period equal to that of Improvement Permit – not to exceed sixty months.

Signed: [signature] date 2/5/03 Installed by: Bobby Mayhew

Improvement Permit by: [signature] date Jan 13 03 Operation Permit by: [signature] RS date 6/13/05

Authorization to Construct by: [signature] RS date 11/18/04 Existing System Inspection by: date

HEALTH DEPT. COPY: WHITE OWNER COPY (FINAL): YELLOW OWNER COPY (INITIAL): PINK

IREDELL COUNTY HEALTH DEPARTMENT

STATESVILLE 704-878-5305 MOORESVILLE 704-664-5281

1:30

IMPROVEMENT PERMIT / AUTHORIZATION TO CONSTRUCT / OPERATION PERMIT / EXISTING SYSTEM INSPECTION

PERMIT# 109469 PIN# 4624 27 5705 .1106 Tax Id Laura 4624475770 DATE Jan 13, 03

OWNER OR CONTRACTOR Crescent Resources LLC / The Point on Norman / HHZ PHONE: Business 375-5999 Home

ADDRESS 2214 Brawley Sch Rd. Mooresville NC 28117

LOCATION Brawley Sch Rd. TL Torrence Chapel Road 2nd on Right

SUBDIVISION The Point BLOCK/SECTION 11 LOT 1106 LOT AREA 55166 ft² SITE CLASS. PS DESIGN FLOW 480gpd L.T.A.R. .225 - .3

Septic Tank: 1600 Gallons; STB Date

Pump Tank: 1000 Gallons; PT Date

Pump Make: Model Serial No.

Nitrification Field: No Fields 1 Square Feet 1500 Linear Feet 500

No Lines 5@100 Trench Width 36" Max Trench Bottom Depth 36" Gravel Depth NA

☑ New System ☐ Repair System Type: I, II, III, IV, V, VI

System Description: pm - 25% Reduction

Repair System Description: LPP BPS

Maintenance Agreement Required: ☐ Yes ☑ No

☑ House/Mod. Home No. Bedrooms 4

☐ Mobile Home No. Bathrooms 4

☐ Business No. Employees

☐ Other


☐ Slab ☑ Crawl Space ☐ Basement w/plumbing ☐ Basement wo/plumbing

Water Supply: ☐ Individual ☑ Public ☐ Community


Comments:/Conditions: Rear yard not evaluated.

Comments:/Conditions: Reviewed Building plans and site plans essentially in compliance with IP. Installed 6 lines ~84' each Pressure, elect & alarm 6/13/05 MK

1"=50' INITIAL SITE SKETCH

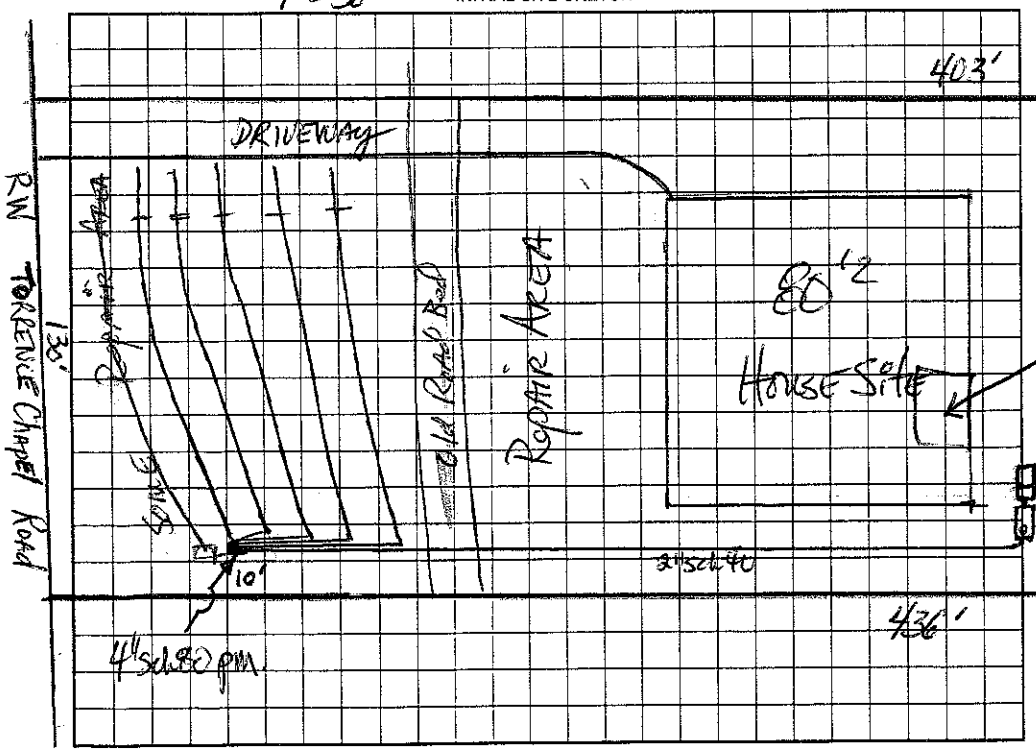

AS BUILT SKETCH

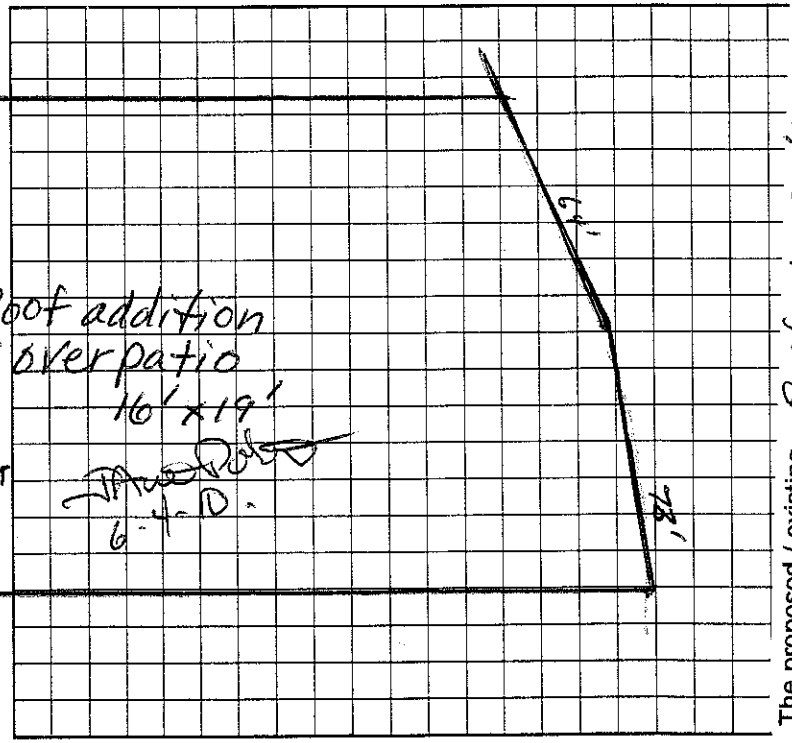

The proposed / ~~existing~~ Roof over patio addition does not appear to impact the existing septic system.

**NOTE:

Date: 6-4-05 REHS

ICHD-Environmental Health Division

Permit can be suspended or revoked if any false information is supplied toward securing the permit/any unauthorized changes are made to the site/any unauthorized changes are made in the installation of the system. Improvement Permit with plat valid without expiration. Improvement Permit with site plan valid for sixty months. Authorization to Construct is valid for a period equal to that of Improvement Permit – not to exceed sixty months.

Signed: date 2/8/03 Installed by: Bobby Mayhew

Improvement Permit by: date Jan 13 03 Operation Permit by: date 6/13/05

Authorization to Construct by: date 11/18/04 Existing System Inspection by: date

HEALTH DEPT. COPY: WHITE OWNER COPY (FINAL): YELLOW OWNER COPY (INITIAL): PINK