IREDELL COUNTY HEALTH DEPARTMENT

STATESVILLE 704-878-5305 MOORESVILLE 704-664-5281

IMPROVEMENT PERMIT / AUTHORIZATION TO CONSTRUCT / OPERATION PERMIT / EXISTING SYSTEM INSPECTION

10-30

PERMIT# 109504 PIN# ~~4624-27-5905~~ 4624476695 DATE Jan 14, 03

OWNER OR CONTRACTOR Crescent Resources dba The Point on Norman Lake PHONE: Business _____ Home _____

ADDRESS 2214 Brawley Sch Rd. Mooresville, N.C. 28117

LOCATION Brawley Sch Rd. TL Torrence Chapel Rd. on Right #154

SUBDIVISION The Point BLOCK / SECTION II LOT 1107 LOT AREA 46,201 ft² SITE CLASS BS DESIGN FLOW 480 gpd L.T.A.R. .25-.3

Septic Tank: 1000 Gallons; STB 338 Date 2-9-07

Pump Tank: 1000 Gallons; PT 27 Date 2-5-07

Pump Make: Goulds Model WE0512HH1U Serial No. _____

Nitrification Field: No Fields ___ Square Feet 1350 Linear Feet 450

No Lines 5@90' Trench Width 36" Max Trench Bottom Depth 36" Gravel Depth NA

☑ New System ☐ Repair System Type: I, II, III, IV, V, VI

System Description: pm - 25% Reduction

Repair System Description: LPPPBPS

Maintenance Agreement Required: ☐ Yes ☑ No, initially

☑ House/Mod. Home ☐ Mobile Home ☐ Business ☐ Other

No. Bedrooms 4 No. Bathrooms 4 No. Employees ___

☐ Slab ☑ Crawl Space ☐ Basement w/plumbing ☐ Basement wo/plumbing

Water Supply: ☐ Individual ☑ Public ☐ Community

Comments:/Conditions: REAR YARD NOT EVALUATED


Installed 0 lines @ 75' ea. EZ Flow

3/1/07


Comments:/Conditions:

1"=50'

INITIAL SITE SKETCH

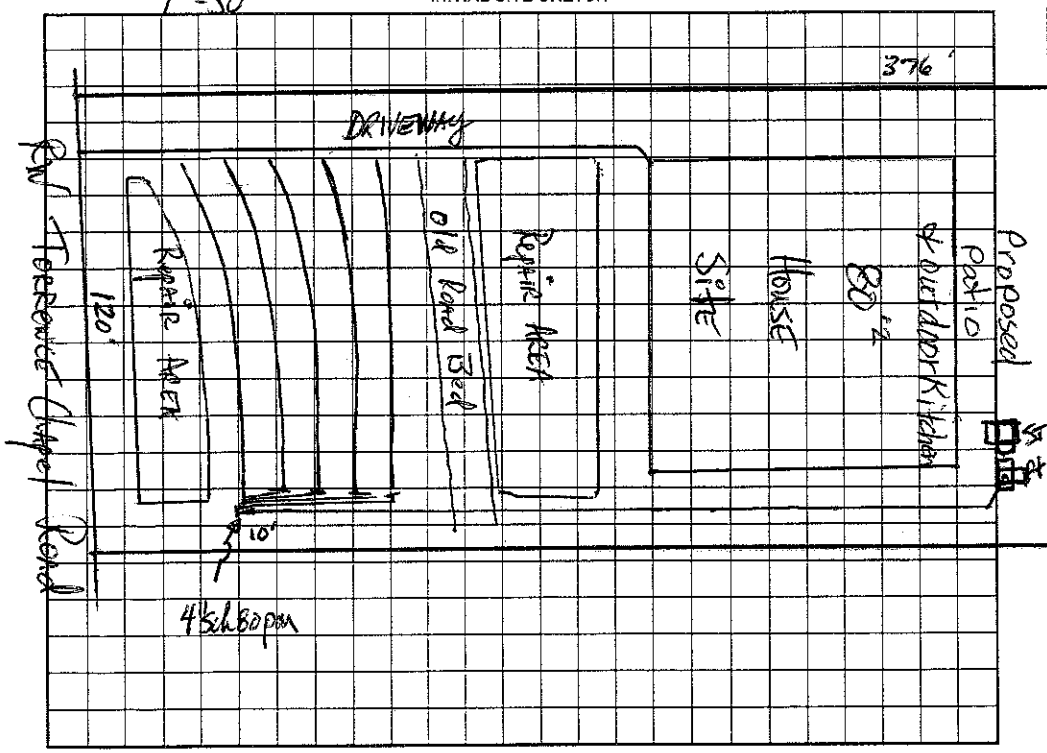

AS BUILT SKETCH

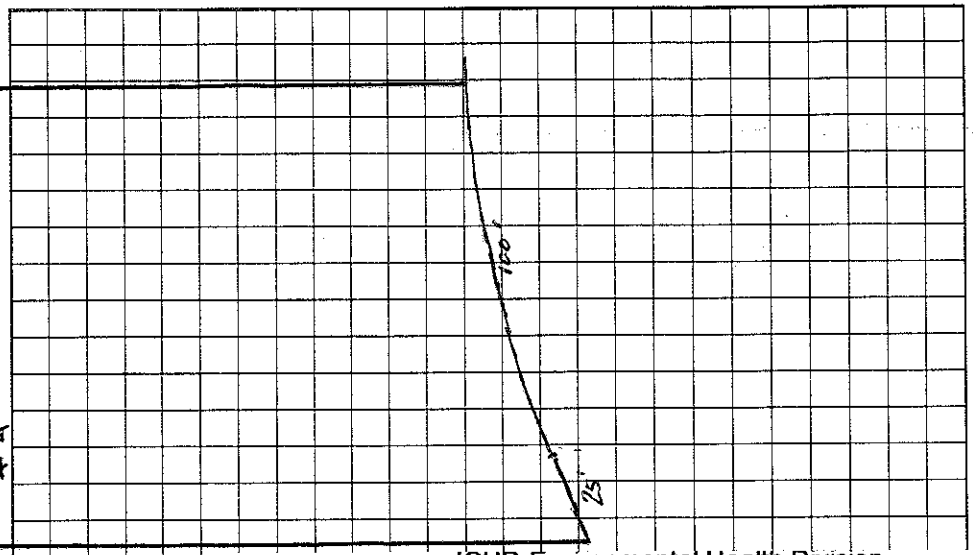

ICHD-Environmental Health Division

The proposed / existing Patio & outdoor Kitchen addition does not appear to impact the existing septic system.

**NOTE: _____

Andy Melville R.S.

Date: 3-26-12

Permit can be suspended or revoked if any false information is supplied toward securing the permit/any unauthorized changes are made to the site/any unauthorized changes are made in the installation of the system. Improvement Permit with plat valid without expiration. Improvement Permit with site plan valid for sixty months. Authorization to Construct is valid for a period equal to that of Improvement Permit – not to exceed sixty months.

Signed: _____ date 2/18/03 Installed by: Bobby Mayhew

Improvement Permit by: Mark Hanson, RS date 1-14-03 Operation Permit by: Mark Hanson RS date 4/26/07

Authorization to Construct by: Andy Melville date 10-30-06 Existing System Inspection by: _____ date _____

HEALTH DEPT. COPY: WHITE OWNER COPY (FINAL): YELLOW OWNER COPY (INITIAL): PINK