IREDELL COUNTY HEALTH DEPARTMENT

STATESVILLE 704-878-5305 MOORESVILLE 704-664-5281

IMPROVEMENT PERMIT / AUTHORIZATION TO CONSTRUCT / OPERATION PERMIT / EXISTING SYSTEM INSPECTION

PERMIT # 33458 PIN # 4624477127 DATE 4-13-09

OWNER or APPLICANT Allin Vesa PHONE: Business 704 875-7028 Home: 704 737 4673

OWNER or APPLICANT ADDRESS 14801 Stonegreen Ln Huntersville, NC

LOCATION / DIRECTIONS Brawley School Rd TL Greyfriars on right (midway down road) #180

SUBDIVISION Cla T BLOCK / SECTION 6 LOT # 530 LOT AREA .715Ac DESIGN FLOW 480gpd L.T.A.R. .3

Septic Tank 1000 Gallons: STB 1000 Date 10-1-08

Pump Tank 1000 Gallons: P T 274 Date 9-18-08

Pump Make ZOELLER Model N-53C Serial #

Nitrification Field No Fields 1 No Lines 6 Linear Feet 267Ft.

Trench Width 24" Max. Trench Bottom Depth 30" Gravel Depth N/A

☒ New System ☐ Repair ☐ Expansion System Type I II III IV V VI

System Description: Pump-Pm-Panel Block

Repair System Description: LPPPBPS + Pretreatment

Maintenance Agreement Required ☐ YES ☒ NO

☐ GRAVITY ☒ PRESSURE

☒ Residence No. Bedrooms 4

☐ Business No. Persons

☐ Other No. Employees

☐ Slab ☐ Crawl Space

☒ Basement w/plumbing ☐ Basement w/o plumbing

Water Supply: ☒ Private ☐ Public ☐ Community

Comments / Conditions: 267Ft = 50% Reduction in Drainfield for 4 Bedrooms

Note: Tank location was changed from previous permit due to change in plumbing stub out.

Comments / Conditions

* Note: Must keep Septic System 50Ft from any well


* See plat from S&MF for Repair

4/17/09 Checked tanks & uppermost 2 line(s).

4/24/09 Checked other 4 lines

INITIAL SITE SKETCH

Scale 1:40

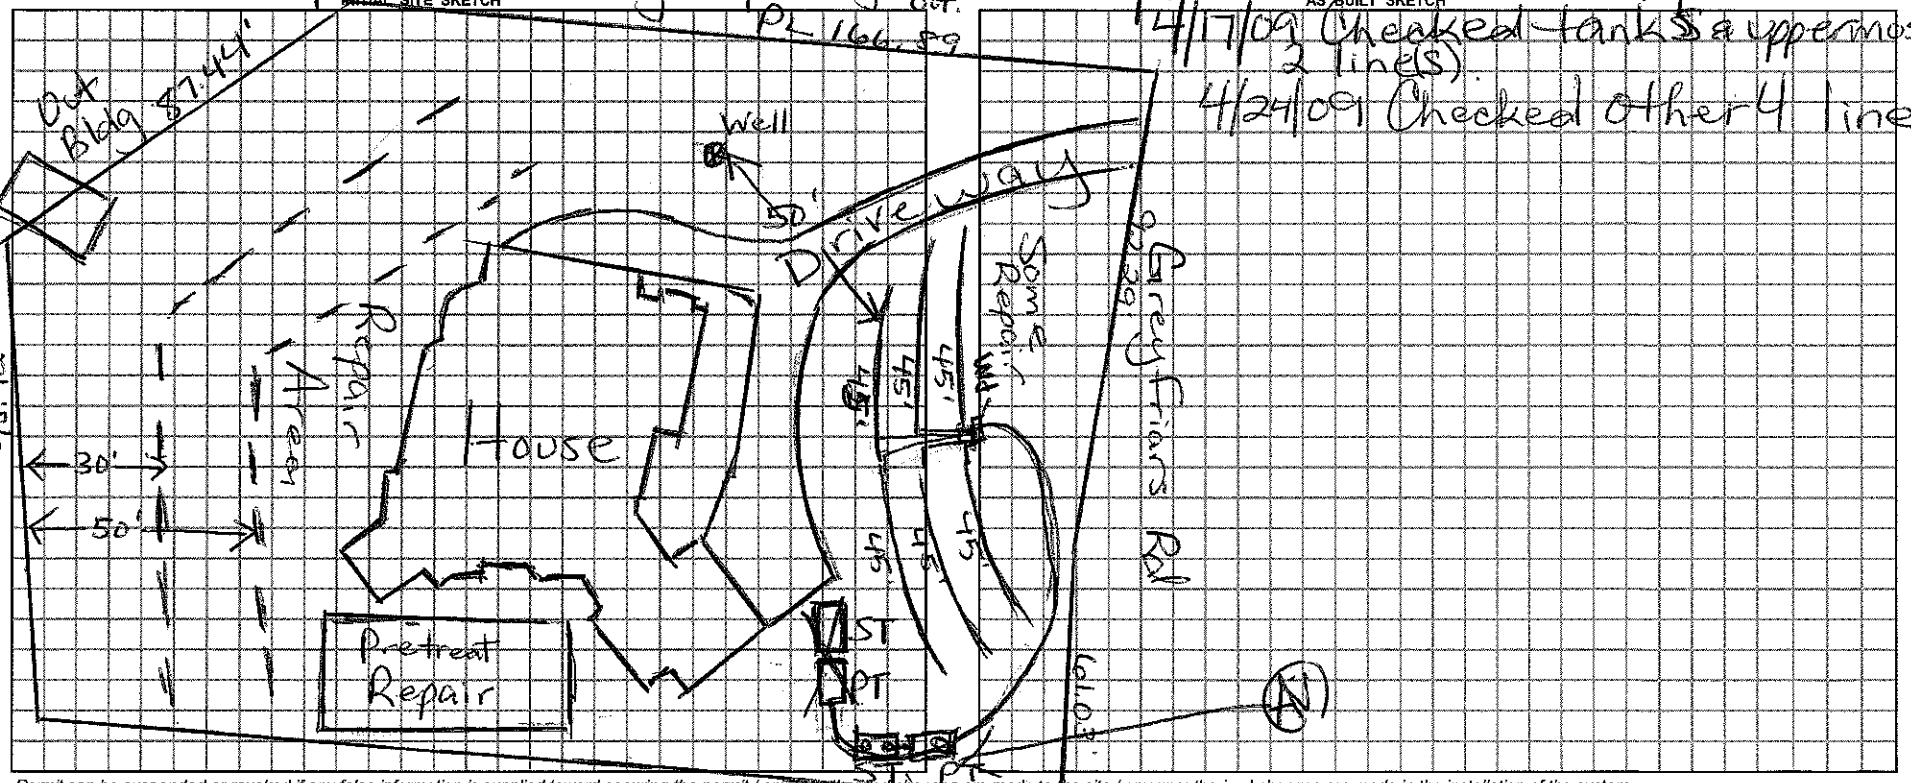

AS BUILT SKETCH

Permit can be suspended or revoked if any false information is supplied toward securing the permit / any unauthorized changes are made to the site / any unauthorized changes are made in the installation of the system.

☐ IMPROVEMENT PERMIT w / plat valid without expiration. ☐ IMPROVEMENT PERMIT w / site plan valid for 60 mos. ☐ AUTHORIZATION TO CONSTRUCT valid for period equal to IMPROVEMENT PERMIT-not to exceed 60 mo.

Owner / Applicant Signature: Allin Vesa Date

Improvement Permit by: Maria H. Coleman RS Date 4/13/09

Authorzation to Construct by: Maria H. Coleman RS Date 4/13/09

YOU SHOULD CONTACT A LOCATOR SERVICE PRIOR TO ANY EXCAVATION.

Installed by: Wayne Clontz

Operation Permit by: Wesley Sparks RS. Date: 8/21/09

Existing System Inspected by: Date:

WHITE COPY Environmental Health YELLOW COPY (Final) Owner / Applicant PINK COPY (Initial) Owner / Applicant