IREDELL COUNTY HEALTH DEPARTMENT

STATESVILLE 704-878-5305 MOORESVILLE 704-664-5281

IMPROVEMENT PERMIT / AUTHORIZATION TO CONSTRUCT / OPERATION PERMIT / EXISTING SYSTEM INSPECTION

PERMIT# 109506 PIN# 4624-27-5705.1109 / Hughes, Homelink & Zande 4624478590 DATE Jan 14, 03

OWNER OR CONTRACTOR Crescent Resources Dev. // The Pointon Norman PHONE: Business (704) 375-5999 Home

ADDRESS 2214 Brawley Sch Rd. Mooresville N.C. 28117

LOCATION Brawley Sch Rd. TL Torrence Chapel Rd on Right

SUBDIVISION The Point BLOCK / SECTION 11 LOT 1109 LOT AREA 30,298 ft² SITE CLASS PS DESIGN FLOW 480 gpd L.T.A.R. .25 - .3

Septic Tank: 1000 Gallons; STB 338 Date 3/15/04

Pump Tank: 1000 Gallons; PT 17 Date 4/8/09

Pump Make: Model Serial No.

Nitrification Field: No Fields 1 Square Feet 1440 Linear Feet 480

No Lines 6 @ 80 Trench Width 36" Max Trench Bottom Depth 36" Gravel Depth NA

☑ New System ☐ Repair System Type: I, II, III, IV, V, VI

System Description: PM 25% Reduction

Repair System Description: LPP BPS

Maintenance Agreement Required: ☐ Yes ☑ No initially

☑ House/Mod. Home ☐ Mobile Home ☐ Business ☐ Other

No. Bedrooms 4 No. Bathrooms 4 No. Employees

☐ Slab ☑ Crawl Space ☐ Basement w/plumbing ☐ Basement wo/plumbing


Water Supply: ☐ Individual ☑ Public ☑ Community

Comments:/Conditions: REAR YARD not EVALUATED


2/13/04 Reviewed plans & essentially in Compliance with original permit

Comments:/Conditions: Reeheck alarm - audible?

1"=50' INITIAL SITE SKETCH 429'

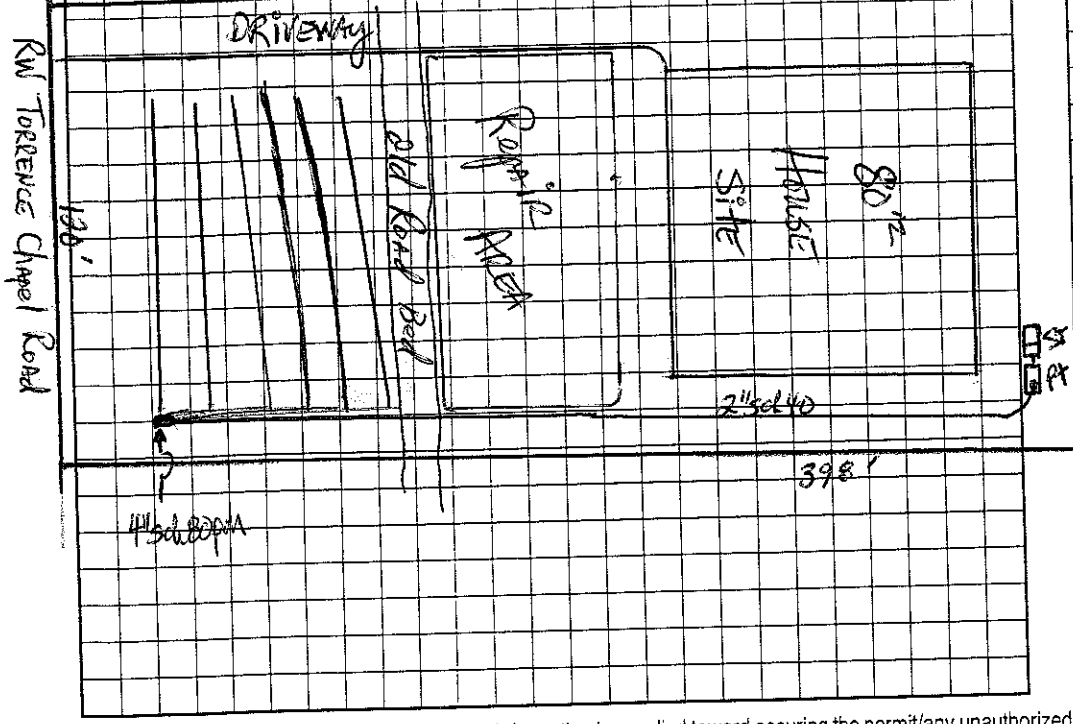

AS BUILT SKETCH

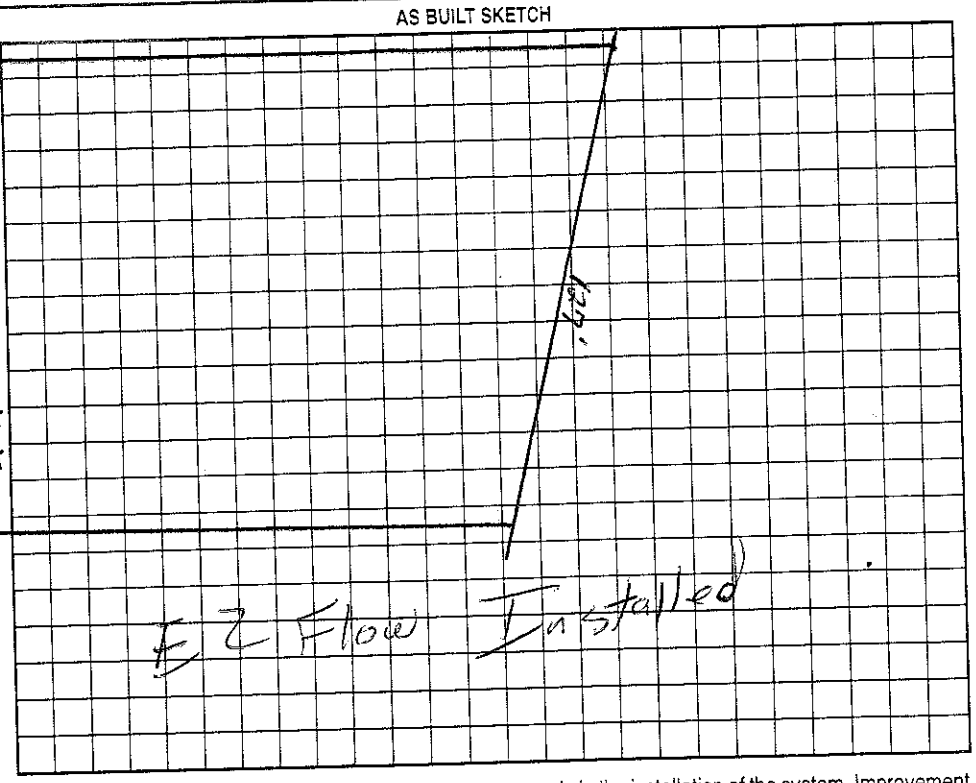

Permit can be suspended or revoked if any false information is supplied toward securing the permit/any unauthorized changes are made to the site/any unauthorized changes are made in the installation of the system. Improvement Permit with plat valid without expiration. Improvement Permit with site plan valid for sixty months. Authorization to Construct is valid for a period equal to that of Improvement Permit – not to exceed sixty months.

Signed: date 1/6/03 Installed by: Bob Mayhew RS

Improvement Permit by: date Jan 14 03 Operation Permit by: date 8/6/04

Authorization to Construct by: date 2/13/04 Existing System Inspection by: date

HEALTH DEPT. COPY: WHITE OWNER COPY (FINAL): YELLOW OWNER COPY (INITIAL): PINK