Existing System

IREDELL COUNTY HEALTH DEPARTMENT

STATESVILLE 704-878-5305 MOORESVILLE 704-664-5281

IMPROVEMENT PERMIT / AUTHORIZATION TO CONSTRUCT / OPERATION PERMIT / EXISTING SYSTEM INSPECTION

PERMIT # 155113 PIN # 4624479083.000 DATE 3/4/09

OWNER or APPLICANT Martha McNellis PHONE: Business 704 662-3046 Home:

OWNER or APPLICANT ADDRESS 192 Greyfriars Rd. Mooresville NC 28117

LOCATION / DIRECTIONS Brawley School Rd. past Traffic circle TL Greyfriars Rd. on Rt.

SUBDIVISION CLYT (Mack Neck) BLOCK / SECTION 6 LOT # 532 LOT AREA DESIGN FLOW Ex. 360 L.T.A.R. Exis

Exis

Septic Tank min 1000 gal Gallons: STB Date

Pump Tank Gallons: P T Date

Pump Make Model Serial #

Nitrification Field No Fields No Lines Linear Feet

Trench Width Max. Trench Bottom Depth Gravel Depth Exis

☐ New System ☐ Repair ☐ Expansion System Type I (II) III IV V VI

System Description: Exis ≈ 12'x35' Bed

Repair System Description:

Maintenance Agreement Required ☐ YES ☑ NO

☑ GRAVITY ☐ PRESSURE

☑ Residence No. Bedrooms 2

☐ Business No. Persons

☐ Other No. Employees

☐ Slab ☑ Crawl Space

☐ Basement w/plumbing ☐ Basement w/o plumbing


Water Supply: ☑ Private well ☐ Public ☐ Community

Comments / Conditions Exis House to change to a 2 BR.
Exis System appears adequate, no visible malfunction
No additional Bedrooms are proposed for additions.


Comments / Conditions

1" = 50'

INITIAL SITE SKETCH

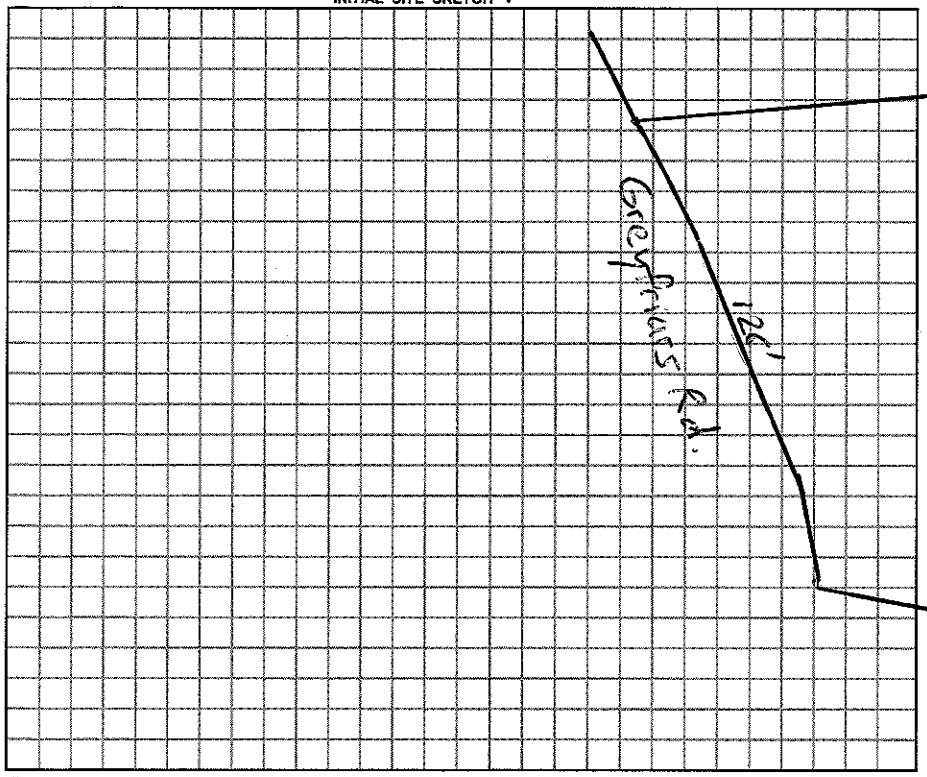

AS BUILT SKETCH

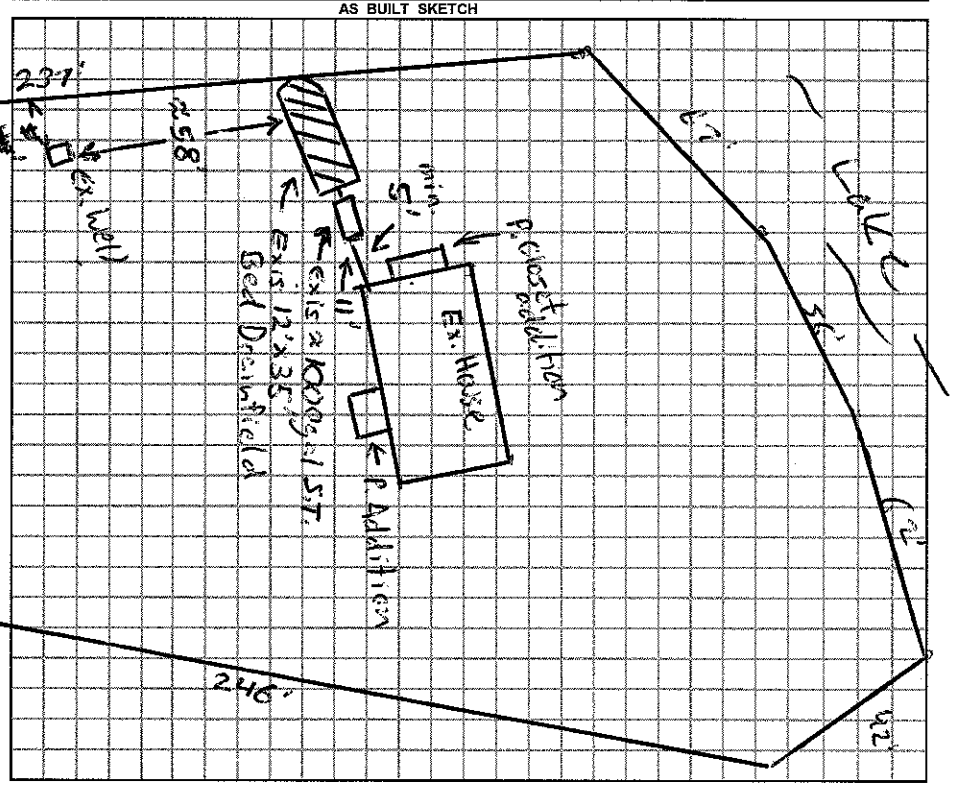

Permit can be suspended or revoked if any false information is supplied toward securing the permit / any unauthorized changes are made to the site / any unauthorized changes are made in the installation of the system.

☐ *IMPROVEMENT PERMIT w / plat valid without expiration.* ☐ *IMPROVEMENT PERMIT w / site plan valid for 60 mos.* ☐ *AUTHORIZATION TO CONSTRUCT valid for period equal to IMPROVEMENT PERMIT-not to exceed 60 mo.*

Owner / Applicant Signature: Date 3-4-09

Improvement Permit by: Date

Authorization to Construct by: Date

YOU SHOULD CONTACT A LOCATOR SERVICE PRIOR TO ANY EXCAVATION.

Installed by:

Operation Permit by: ✓ Date:

Existing System Inspected by: Anthony Coker for RS Date: 3/4/09

WHITE COPY Environmental Health YELLOW COPY (Final) Owner / Applicant PINK COPY (Initial) Owner / Applicant