IREDELL COUNTY HEALTH DEPARTMENT

STATESVILLE 704-878-5305 MOORESVILLE 704-664-5281

IMPROVEMENT PERMIT / AUTHORIZATION TO CONSTRUCT / OPERATION PERMIT / EXISTING SYSTEM INSPECTIO

PERMIT# 104507 PIN# 4624 27 5705 .1110 4624479483 Brett DATE Jan 21, 03

OWNER OR CONTRACTOR Cougar Resources Inc / The Pointe at Norman / Hughes, Hamel PHONE: Business 363-6390 Home

ADDRESS 2214 Brawley School Rd. Mooresville N.C. 28117

LOCATION Brawley School RD TL Torrence Chapel & 7 and 8 on Right

SUBDIVISION The Point BLOCK / SECTION 11 LOT 1110 LOT AREA 57379 ft² SITE CLASS PS DESIGN FLOW 480 gpd L.T.A.R. 2.3

Septic Tank: 1000 Gallons; STB 335 Date 1-18-04
Pump Tank: 1000 Gallons; PT 29 Date 1-19-04
Pump Make Goulds, Model 1 3HP WE03512 No. A045E 256
Nitrification Field: No Fields 1 Square Feet 1200 Linear Feet 400
No Lines 5@80' Trench Width 36" Max Trench Bottom Depth 36"

☑ New System ☐ Repair System Type: I, II, III, IV, V, VI
System Description: pm - 25% Reduction
Repair System Description: LP PFBPS
Maintenance Agreement Required: ☐ Yes ☑ No initially

☑ House/Mod. Home ☐ Mobile Home ☐ Business ☐ Other
No. Bedrooms 4 No. Bathrooms 4 No. Employees


Water Supply: ☐ Individual ☑ Public ☑ Community

Gravel Depth NA ☐ Slab ☑ Crawl Space ☐ Basement w/plumbing ☐ Basement wo/plumbing


Comments:/Conditions: Rear yard not evaluated.
Reviewed Building plans 9/30/03, essentially in Compliance with Improvement Permit.
Place house 160 ft from road.

Comments:/Conditions: Installed E7, Flow as Drawn 5@50' lines. Heatbeat lines 1/14/04 Pressure, elect. & alarm 3/12/04 MD

1"=50'
INITIAL SITE SKETCH

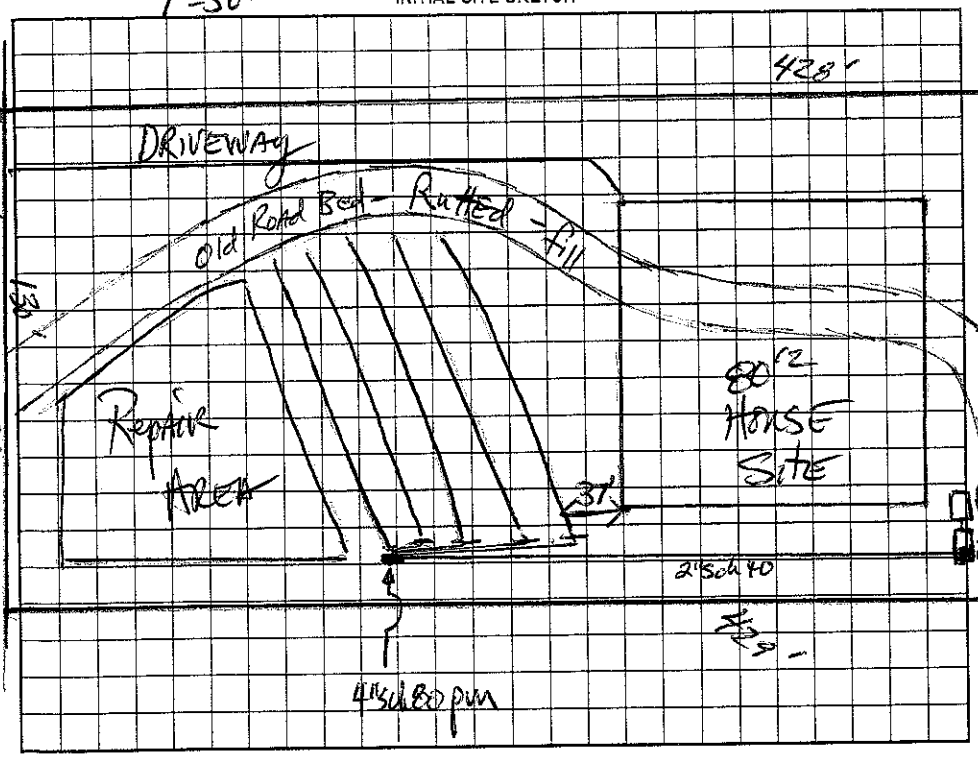

AS BUILT SKETCH

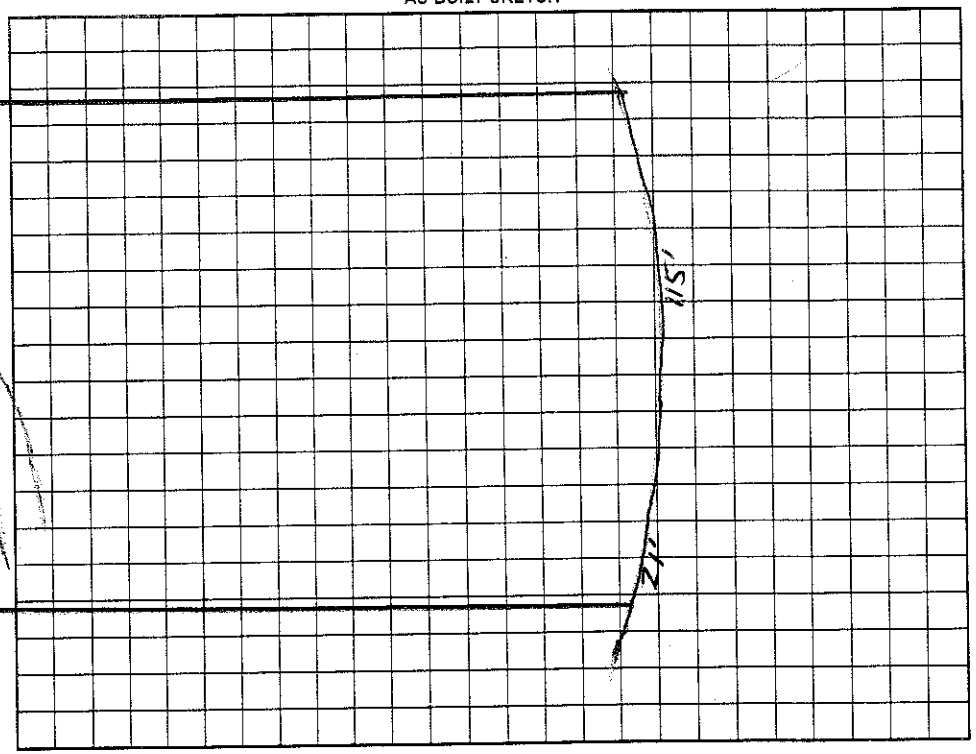

Permit can be suspended or revoked if any false information is supplied toward securing the permit/any unauthorized changes are made to the site/any unauthorized changes are made in the installation of the system. Improvement Permit with plat valid without expiration. Improvement Permit with site plan valid for sixty months. Authorization to Construct is valid for a period equal to that of Improvement Permit – not to exceed sixty months.

Signed: _____ date 2/5/03
Improvement Permit by: _____ RS date Jan 21, 03
Authorization to Construct by: _____ RS date 10/1/03

Installed by: Bobby Mayhew RS
Operation Permit by: _____ date 3/12/04
Existing System Inspection by: _____ date

HEALTH DEPT. COPY: WHITE OWNER COPY (FINAL): YELLOW OWNER COPY (INITIAL): PINK