10:30

IREDELL COUNTY HEALTH DEPARTMENT

STATESVILLE 704-878-5305 MOORESVILLE 704-664-528

IMPROVEMENT PERMIT / AUTHORIZATION TO CONSTRUCT / OPERATION PERMIT / EXISTING SYSTEM INSP.

PERMIT# 109606 PIN# 4624-27-5705 #181 4624479934 DATE Feb 10, 03

OWNER OR CONTRACTOR Crescent Resources c/o The Preston Partners HHZ PHONE: Business _____ Home _____

ADDRESS 2214 Brawley Sch Rd Mooresville, N.C. 28115

LOCATION Brawley Sch Rd TL Torrence Chapel Rd Lot on left SFE on Right 155 Torrence Chapel

SUBDIVISION The Point BLOCK / SECTION 11 LOT 11B1/11B1A LOT AREA 40,479ft² + 27,053 ft² SITE CLASS PS SFE DESIGN FLOW 450gpd L.T.A.R. 0.3 SFE #181A

Septic Tank: ~~1000~~ 1500 Gallons; STB 338 Date 8-23-05

Pump Tank: 1000 Gallons; PT 27 Date 8-27-05

Pump Make: Goulds Model WE0512HH Serial No. H0526064

Nitrification Field: No Fields 1 Square Feet 1350 Linear Feet 450

No Lines 5 @ 90' Trench Width 36" Max Trench Bottom Depth 36" Gravel Depth N/A

☑ New System ☐ Repair System Type: I, II, III, IV, V, VI

System Description: PA - 25% Reduction on SFE #181A

Repair System Description: LP PP BPS

Maintenance Agreement Required: ☐ Yes ☑ No, initially

☑ House/Mod. Home ☐ Mobile Home ☐ Business ☐ Other

No. Bedrooms 4 No. Bathrooms 4 No. Employees ____

☐ Slab ☑ Crawl Space ☐ Basement w/plumbing ☐ Basement wo/plumbing


Water Supply: ☐ Individual ~~☐ Public~~ ☑ Community

Comments:/Conditions: Reviewed Building plans & site plans 4/27/05; in Compliance with original permit.

Comments:/Conditions: Checked Drainfield 9/29/05; installed EZ Flow as Drawn Checked pressure, cleat & alarm

1" = 100'

INITIAL SITE SKETCH

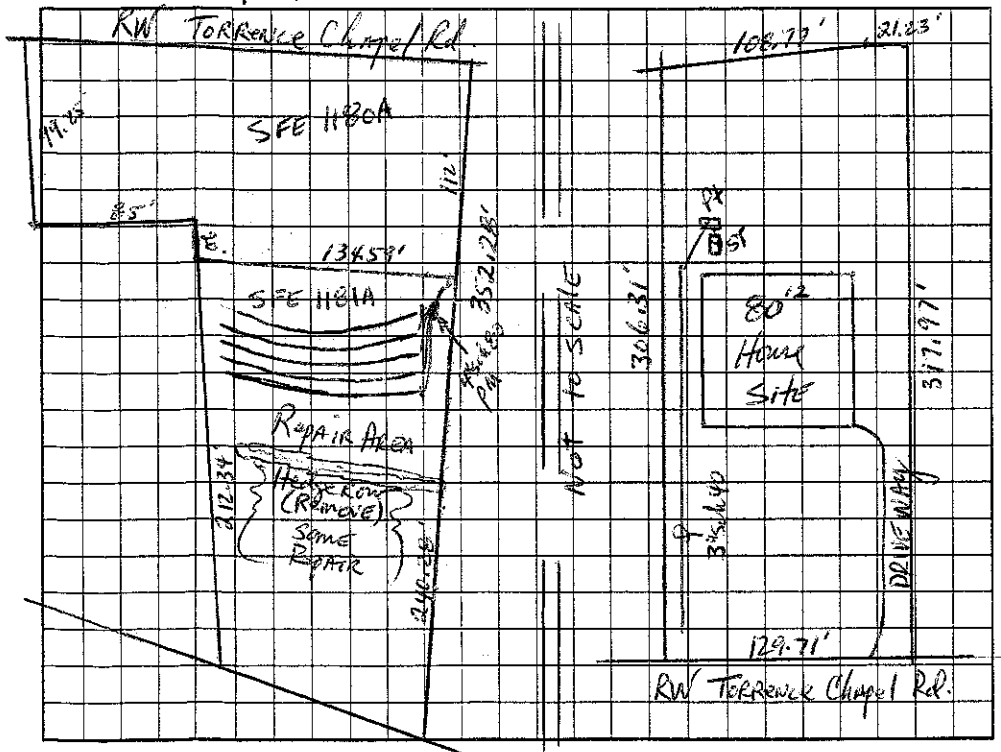

AS BUILT SKETCH

Permit can be suspended or revoked if any false information is supplied toward securing the permit/any unauthorized changes are made to the site/any unauthorized changes are made in the installation of the system. Improvement Permit with plat valid without expiration. Improvement Permit with site plan valid for sixty months. Authorization to Construct is valid for a period equal to that of Improvement Permit – not to exceed sixty months.

Permit by: _____ date 2/10/03

Construct by: _____ date 4/27/05

Installed by: Bobby Mayhew

Operation Permit by: _____ date 11/4/05

Existing System Inspection by: _____ date _____

HEALTH DEPT. COPY: WHITE OWNER COPY (FINAL): YELLOW OWNER COPY (INITIAL): PINK