IREDELL COUNTY HEALTH DEPARTMENT

STATESVILLE 704-878-5305 MOORESVILLE 704-664-5281

IMPROVEMENT PERMIT / AUTHORIZATION TO CONSTRUCT / OPERATION PERMIT / EXISTING SYSTEM INSPECTION

PERMIT# 070924 PIN# 4625941684 PT 4624-48-1693 DATE 12/31/97

OWNER OR CONTRACTOR CRESCENT RESOURCES PHONE: Business 663-6905 T JACOBS Home

ADDRESS 17405 SETTON RD. CORNELIUS NC 28031

LOCATION BRAWLEY SCHOOL RD. .25 MILE BEFORE STONEMARKER ON RT

SUBDIVISION BLOCK / SECTION LOT LOT AREA .83AC SITE CLASS. PS DESIGN FLOW 480 L.T.A.R. .3

Septic Tank: 1000 Gallons; STB 794 Date 1/10/98
Pump Tank: Gallons; PT Date
Pump Make: Model Serial No.
Nitrification Field: No Fields 1 Square Feet 1200 Linear Feet 400
No Lines 5@80' Trench Width 36" Max Trench Bottom Depth 36" Gravel Depth N/A

☑ New System ☐ Repair System Type: I, II, (III) IV, V, VI
System Description: GRAVITY CHAMBERED ORIDS
Repair System Description: GRAVITY PANEL
Maintenance Agreement Required: ☐ Yes ☑ No

☑ House/Mod. Home No. Bedrooms 4
☐ Mobile Home No. Bathrooms 4
☑ Business * No. Employees 10
☐ Other
☐ Slab ☑ Crawl Space ☑ Basement w/plumbing ☐ Basement wo/plumbing


Water Supply: ☑ Individual ☐ Public ☐ Community

Comments:/Conditions: SYSTEM SIZED FOR 4BR HOUSE AT 480 GPD. - OFFICES WILL CONSIST OF 10 EMPLOYEES AT 25 GPD PER EMLOYEE.


Comments:/Conditions: LOWER 4 LINES & TANK CHECKED

1"=50'

INITIAL SITE SKETCH

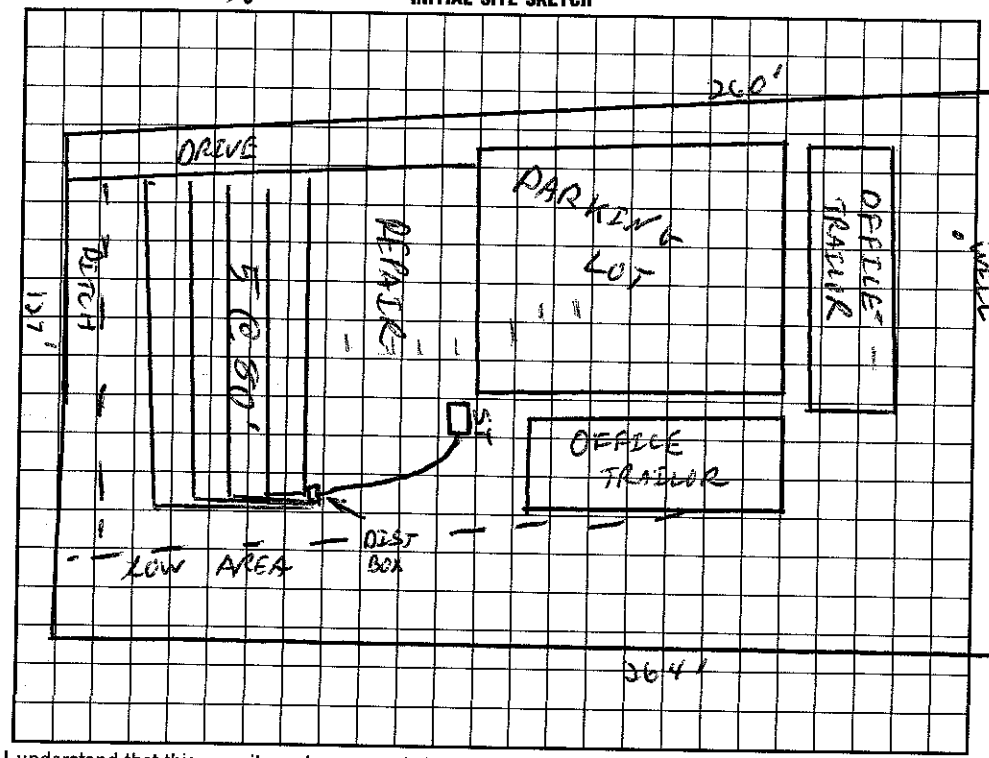

AS BUILT SKETCH

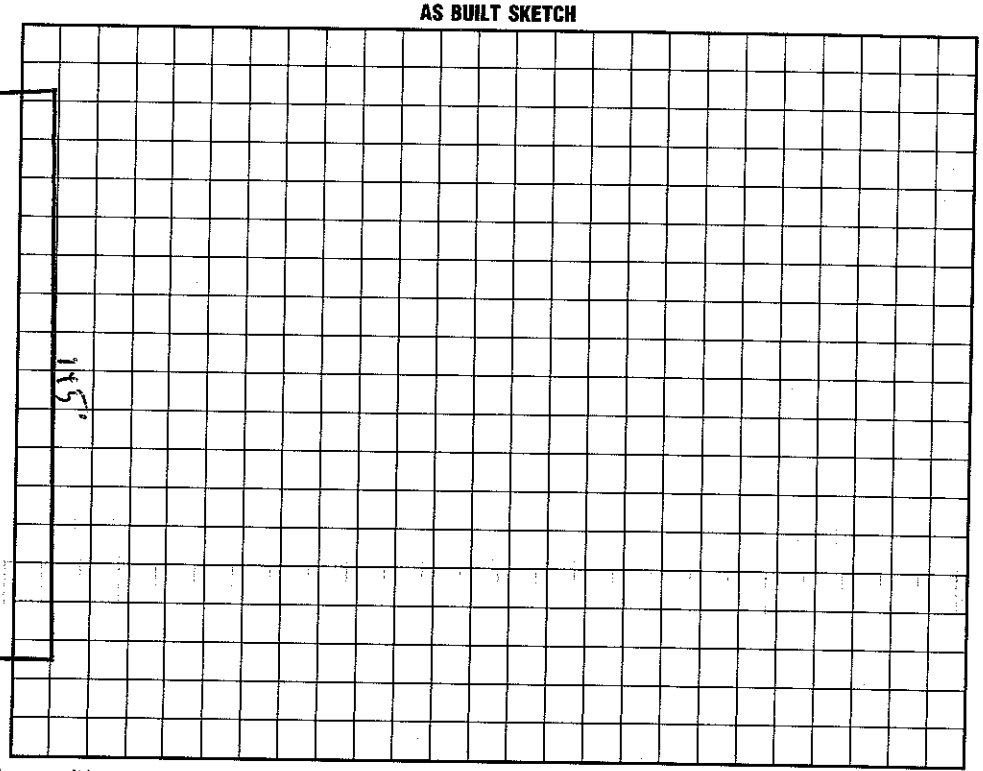

I understand that this permit can be suspended or revoked if any false information is supplied toward securing the permit/any unauthorized changes are made to the site/any unauthorized changes are made in the installation of the system. Improvement Permit with plat valid without expiration. Improvement Permit with site plan valid for sixty months. Authorization to Construct is valid for a period equal to that of Improvement Permit – not to exceed sixty months.

Signed: Tony C Jacobs date 1-2-98 Installed by: MAYHEW & CHARLES

Improvement Permit by: C. Ray Freeman date 12/31/97 Operation Permit by: date

Authorization to Construct by: C. Ray Freeman date 12/31/97 Existing System Inspection by: C. Ray Freeman date 3/3/98

HEALTH DEPT. COPY: WHITE INSPECTION COPY (FINAL): GREEN OWNER COPY (FINAL): YELLOW INSPECTION COPY (INITIAL): PINK OWNER COPY (INITIAL): GOLD