IREDELL COUNTY HEALTH DEPARTMENT

SVILLE 704-878-5305 MOORESVILLE 704-664-5281

IMPROVEMENT PERMIT / AUTHORIZATION TO CONSTRUCT / OPERATION PERMIT / EXISTING SYSTEM INSPECTION

PERMIT# 109629 PIN# ~~4624-27-5705.11187~~ 4624482403 DATE Feb 7, 03

OWNER OR CONTRACTOR Crescent Resources dba/ The Point on Norman Beaten Hom PHONE: Business Home

ADDRESS 2214 Brawley Sch Rd. Mooresville NC 28117

LOCATION Brawley Sch Rd TL Torrence Chapel 1st lot on left ~~5~~ corner lot

SUBDIVISION The Point BLOCK / SECTION 11 LOT 1187 LOT AREA 67117 ft² SITE CLASS. ~~P~~ 5 DESIGN FLOW 480gpd L.T.A.R. ~.25

Septic Tank ~~1000~~ 1500 Gallons; STB Date 8/23/05

Pump Tank: Gallons; PT Date

Pump Make: Model Serial No.

Nitrification Field: ~~No Fields~~ 1 Square Feet 1440 Linear Feet 480

No Lines ~~3~~ 4 ~~120'EA~~ Trench Width 36" Max Trench Bottom Depth ~~46"~~ 48"

☐ ~~New System~~ ☐ Repair System Type: I, II, III, IV, V, VI

System Description: Gravity 25% Reduction

Repair System Description: Gravity 25% Reduction

Maintenance Agreement Required: ☐ Yes ☑ No

Gravel Depth N/A

☑ ~~House/Mod. Home~~ No. Bedrooms ~~3~~ 4

☐ Mobile Home No. Bathrooms

☐ Business No. Employees

☐ Other

☐ Slab ☑ Crawl Space ☐ Basement w/plumbing ☐ Basement wo/plumbing

Water Supply: ☐ Individual ☑ ~~Public~~ ☐ Community


Comments/Conditions:

Comments/Conditions:

* INSTALL LATERALS between 42" and 48" trench bottom depth


1"=50'

INITIAL SITE SKETCH

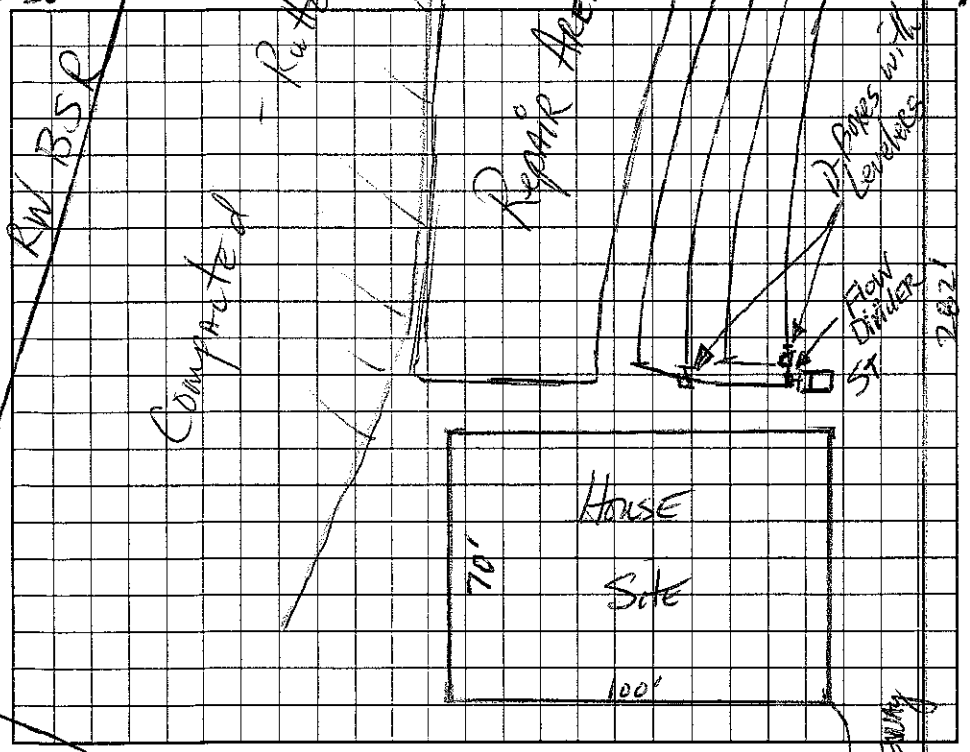

1"=50'

AS BUILT SKETCH

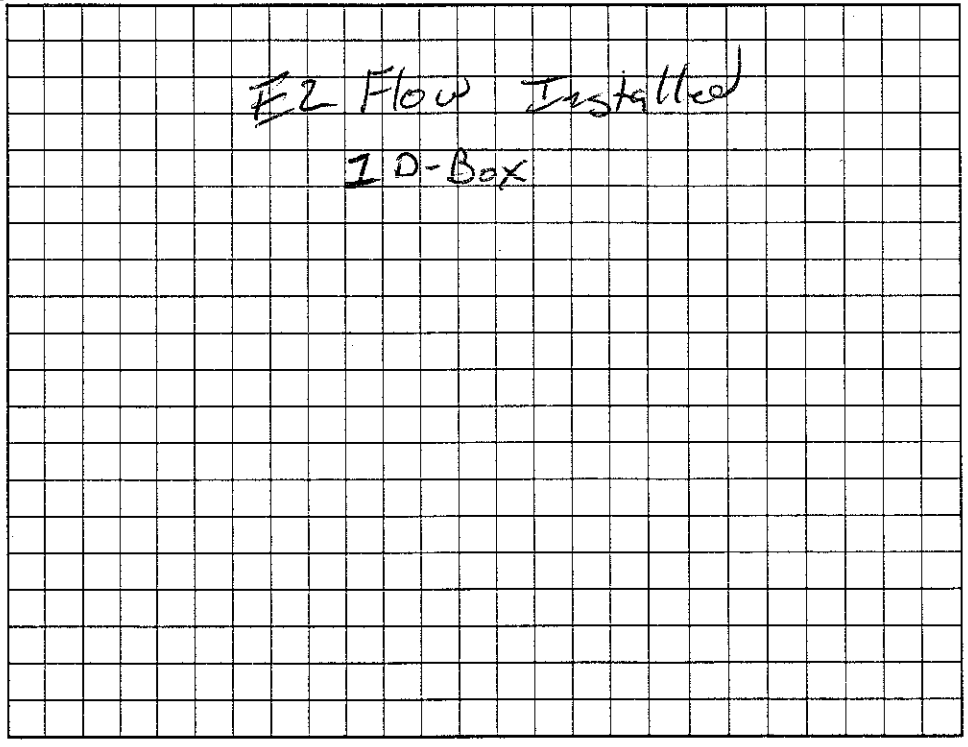

Permit can be suspended or revoked if any false information is supplied toward securing the permit, any unauthorized changes are made to the site, any unauthorized changes are made in the installation of the system. Improvement Permit with plat valid without expiration. Improvement Permit with site plan valid for sixty months. Authorization to Construct is valid for a period equal to that of Improvement Permit – not to exceed sixty months.

Signed: RW date 2/12/03 Installed by: Hall Man

Improvement Permit by: date 2/7/03 Operation Permit by: date 9/28/05

Authorization to Construct by: date 4/4/05 Existing System Inspection by: date

HEALTH DEPT. COPY: WHITE OWNER COPY (FINAL): YELLOW OWNER COPY (INITIAL): PINK