50.00 Paid 2100

IREDELL COUNTY HEALTH DEPARTMENT

STATESVILLE 704-878-5305 MOORESVILLE 704-664-5281

IMPROVEMENT PERMIT / AUTHORIZATION TO CONSTRUCT / OPERATION PERMIT / EXISTING SYSTEM INSPECTION

PERMIT# 109628 PIN# ~~4624-27-5705.1186~~ 4624483268 DATE 10/17/05

OWNER OR APPLICANT Kenneth Beaver Homes PHONE: Business 704 746-4669 Home

ADDRESS PO Box 5378 Mooresville NC 28117

LOCATION BSR + T L Torrence Chapel 2nd on Lt.

SUBDIVISION Point BLOCK / SECTION II LOT 11 86 LOT AREA 48,354 Ft² SITE CLASS. PS DESIGN FLOW 600 L.T.A.R. 0.25

Septic Tank: 1500 Gallons; STB 338 Date 9-26-05

Pump Tank: Gallons; PT Date

Pump Make: Model Serial No.

Nitrification Field: No Fields 1 Square Feet 1800 Linear Feet 600

No Lines 6@100' Trench Width 36" Max Trench Bottom Depth 48" Gravel Depth —

☒ New System ☐ Repair ☐ Expansion System Type: I II III IV V VI

System Description: Gravity 25% Reduct

Repair System Description: LP Paul Block

Maintenance Agreement Required: ☐ Yes ☒ No

☒ House/Mod. Home ☐ Mobile Home ☐ Business ☐ Other

No. Bedrooms 5 No. Persons No. Employees


Water Supply: ☐ Individual ☐ Public ☒ Community

☐ Gravity ☐ Pressure ☐ Slab ☒ Crawl Space ☐ Basement w/plumbing ☐ Basement wo/plumbing

Comments:/Conditions:

Comments:/Conditions:

INITIAL SITE SKETCH

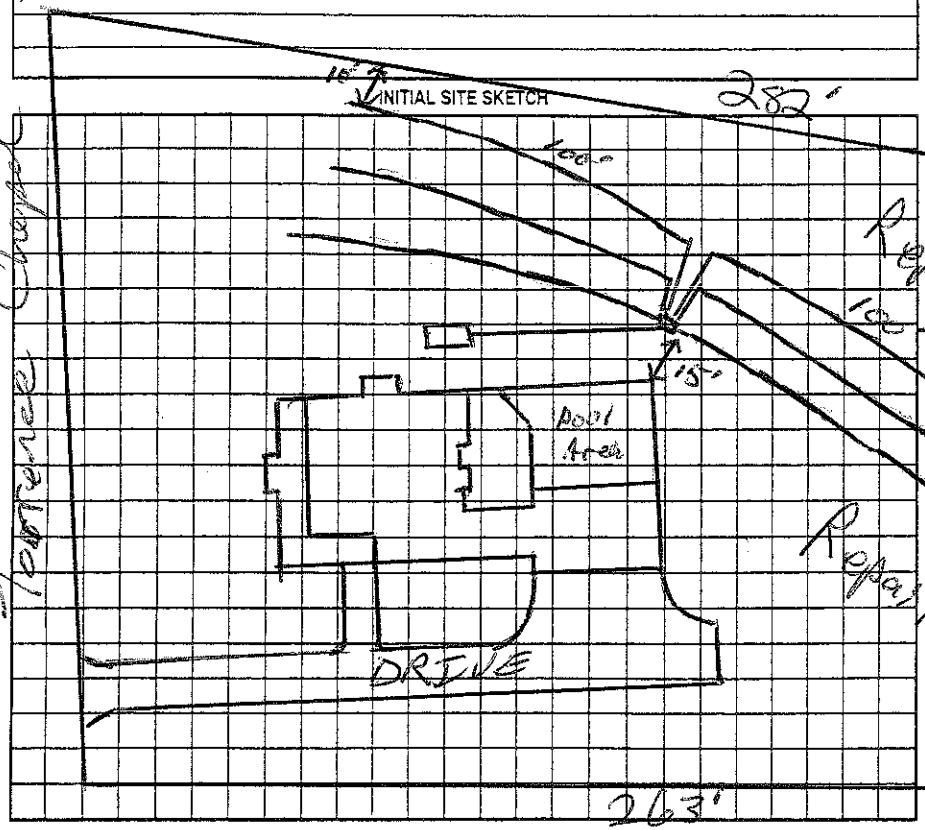

AS BUILT SKETCH

Installed E/Z Flow for Drainfield

Installed essentially as Drawn

Permit can be suspended or revoked if any false information is supplied toward securing the permit/any unauthorized changes are made to the site/any unauthorized changes are made in the installation of the system. Improvement Permit with plat valid without expiration ☐ Improvement Permit with site plan valid for sixty months ☒ Authorization to Construct is valid for a period equal to that of Improvement Permit – not to exceed sixty months.

Signed: date 10-20-05 Installed by: Hallman Construction

Improvement Permit by: RS date 10/17/05 Operation Permit by: Marvin Dotson RS date 10/28/05

Authorization to Construct by: RS date 10/17/05 Existing System Inspection by: date

HEALTH DEPT. COPY: WHITE OWNER COPY (FINAL): YELLOW OWNER COPY (INITIAL): PINK