IREDELL COUNTY HEALTH DEPARTMENT

STATESVILLE 704-878-5305 MOORESVILLE 704-664-5281

IMPROVEMENT PERMIT / AUTHORIZATION TO CONSTRUCT / OPERATION PERMIT / EXISTING SYSTEM INSPECTION

PERMIT# 109626 PIN# 4624-27-5795.1185 DATE Feb 7, 03

OWNER OR CONTRACTOR Crescent Resources dba/ The Point or Normon / Zande Homes Business Home

ADDRESS 2214 Brawley Sch Rd. Mooresville NC 28117

LOCATION Brawley Sch Rd TL Torrence Chapel Rd. on left

SUBDIVISION The Point BLOCK / SECTION 11 LOT 1185 LOT AREA 35,244 sf SITE CLASS PS DESIGN FLOW 440 gpd L.T.A.R. .25-.3

Septic Tank: 1000 Gallons; STB 534 Date 2/16/05

Pump Tank: Gallons; PT Date

Pump Make: Model Serial No.

Nitrification Field: No. Fields 2 Square Feet 1320 Linear Feet 440

No. Lines 2+2 110' ea. Trench Width 36" Max Trench Bottom Depth 36" Gravel Depth N/A

☑ New System ☐ Repair System Type: I, II, III, IV, V, VI

System Description: Gravity 25% Reduction

Repair System Description: Gravity LPP 25-50% Reduction

Maintenance Agreement Required: ☐ Yes ☑ No

☑ House/Mod. Home ☐ Mobile Home ☐ Business ☐ Other

No. Bedrooms 4 No. Bathrooms 4 No. Employees

☐ Slab ☑ Crawl Space ☐ Basement w/plumbing ☐ Basement wo/plumbing


Water Supply: ☐ Individual ☑ Public ☐ Community

Comments/Conditions: 9/22/05 Reviewed Building plans & site plan; in compliance with original permit.

Comments/Conditions: ★★ Do not over cut for house pad, otherwise drainfield may be compromised & system will have to be pumped.

1"=50'

INITIAL SITE SKETCH

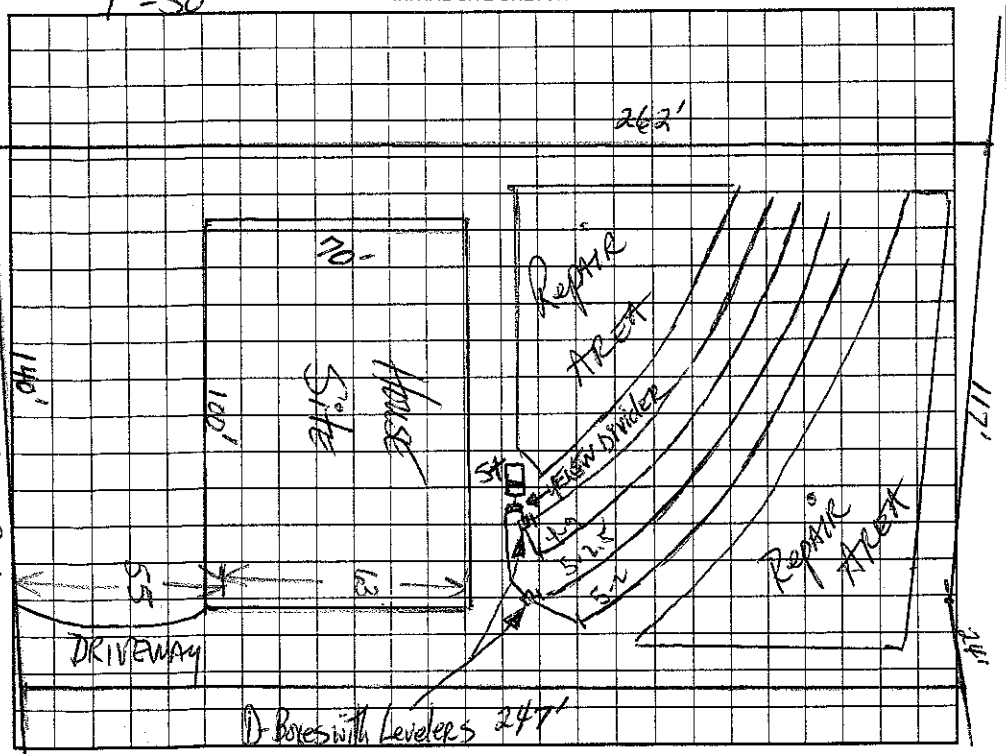

AS BUILT SKETCH

Permit can be suspended or revoked if any false information is supplied toward securing the permit/any unauthorized changes are made to the site/any unauthorized changes are made in the installation of the system. Improvement Permit with plat valid without expiration. Improvement Permit with site plan valid for sixty months. Authorization to Construct is valid for a period equal to that of Improvement Permit – not to exceed sixty months.

Signed: date 2/16/05

Improvement Permit by: date 2/7/03

Authorization to Construct by: Maria H. Dotson RS date 9/22/05

Installed by: Stanley Septic Service

Operation Permit by: Wesley Sparks R.S. date 1/27/06

Existing System Inspection by: date

HEALTH DEPT. COPY: WHITE OWNER COPY (FINAL): YELLOW OWNER COPY (INITIAL): PINK