IREDELL COUNTY HEALTH DEPARTMENT

STATESVILLE 704-878-5305 MOORESVILLE 704-663-5281

IMPROVEMENT PERMIT / AUTHORIZATION TO CONSTRUCT / OPERATION PERMIT / EXISTING SYSTEM INSPECTION

PERMIT# 151026 PIN# ~~4624 27 5705 1135~~ 4624 48 4199 DATE 6/23/08

OWNER OR APPLICANT MATTHEW RAWLING PHONE: Business Home 764-663-7505

ADDRESS 131 TORRENCE CHAPEL RD. MOORESVILLE, NC. 28117

LOCATION 1100 TL TORRENCE CHAPEL ON L #131

SUBDIVISION POINT BLOCK / SECTION 11 LOT 1185 LOT AREA .815 SITE CLASS. PS DESIGN FLOW 480 L.T.A.R. .3

Septic Tank: 1000 Gallons: STB Date

Pump Tank: Gallons: PT Date

Pump Make: Model Serial No.

Nitrification Field: No Fields 1 Square Feet 1320 Linear Feet 440

No Lines 4@110' Trench Width 3' Max Trench Bottom Depth 3'

☐ New System ☐ Repair ☐ Expansion System Type: I II III IV V VI

System Description: ACCEPTED - 25% REDUCTION

Repair System Description: LP - 16" PPDPS

Maintenance Agreement Required: ☐ Yes ☒ No

Gravel Depth NA ☒ Gravity ☐ Pressure ☐ Slab ☒ Crawl Space ☐ Basement w/plumbing ☐ Basement wo/plumbing

☒ House/Mod. Home ☐ Mobile Home ☐ Business ☐ Other

No. Bedrooms 4 No. Persons No. Employees


Water Supply: ☐ Individual ☐ Public ☒ Community

Comments:/Conditions:

Comments:/Conditions:

INITIAL SITE SKETCH

AS BUILT SKETCH

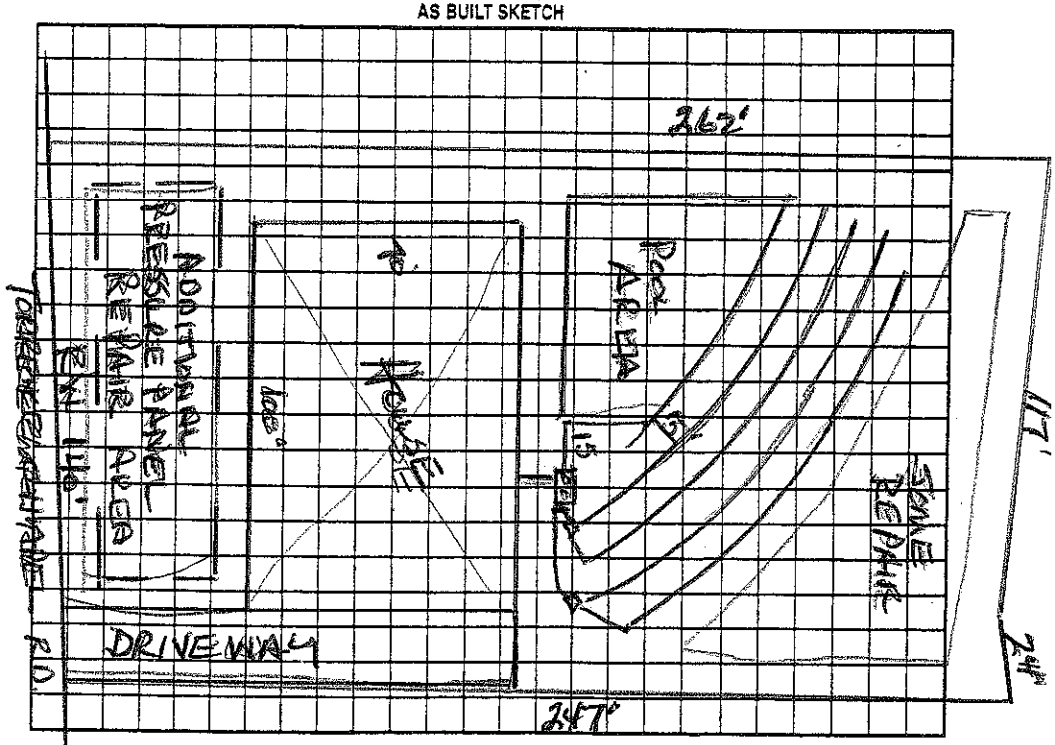

Permit can be suspended or revoked if any false information is supplied toward securing the permit/any unauthorized changes are made to the site/any unauthorized changes are made in the installation of the system. Improvement Permit with plat valid without expiration ☐ Improvement Permit with site plan valid for sixty months ☐ Authorization to Construct is valid for a period equal to that of Improvement Permit – not to exceed sixty months.

Signed: date 6/25/08

Improvement Permit by: date

Authorization to Construct by: date

Installed by: Stanley Septic Tank

Operation Permit by: Wesley Sparkes date 6/23/08

Existing System Inspection by: date

HEALTH DEPT. COPY: WHITE OWNER COPY (FINAL): YELLOW OWNER COPY (INITIAL): PINK