IREDELL COUNTY HEALTH DEPARTMENT

STATESVILLE [illegible]-5305 MOORESVILLE 704-664-5281

100.00 Paid

IMPROVEMENT PERMIT / AUTHORIZATION TO CONSTRUCT / OPERATION PERMIT / EXISTING SYSTEM INSPECTION

PERMIT# 109598 PIN# 4624-27-5705.469 4624485600 DATE 11/28/05

OWNER OR APPLICANT Lifestyle Custom Homes PHONE: Business 980-721-0917 Home

ADDRESS 5706 Bucke St Charlotte NC

LOCATION BSR, TL Torrence Chapel, TL Shelburn, TL Cape Cod, TL Hyannis Ct at End

SUBDIVISION Point BLOCK / SECTION 11 LOT 1169 LOT AREA 84,043 sf SITE CLASS. PS DESIGN FLOW 600 L.T.A.R. 0.25

Septic Tank: 1500 Gallons; STB 3388 Date 7/25/06
Pump Tank: Gallons; PT Date
Pump Make: Model Serial No.
Nitrification Field: No Fields 1 Square Feet 1800 Linear Feet 600
No Lines 4@150' Trench Width 36" Max Trench Bottom Depth 36" Gravel Depth —

☒ New System ☐ Repair ☐ Expansion System Type: I II III IV V VI
System Description: Gravity 25% Reduction
Repair System Description: LP Panel Block
Maintenance Agreement Required: ☐ Yes ☒ No
☒ Gravity ☐ Pressure


☒ House/Mod. Home ☐ Mobile Home ☐ Business ☐ Other
No. Bedrooms 5 No. Persons No. Employees

Water Supply: ☐ Individual ☐ Public ☒ Community

☐ Slab ☒ Crawl Space ☐ Basement w/plumbing ☐ Basement wo/plumbing


Comments:/Conditions:
1"=60'

INITIAL SITE SKETCH

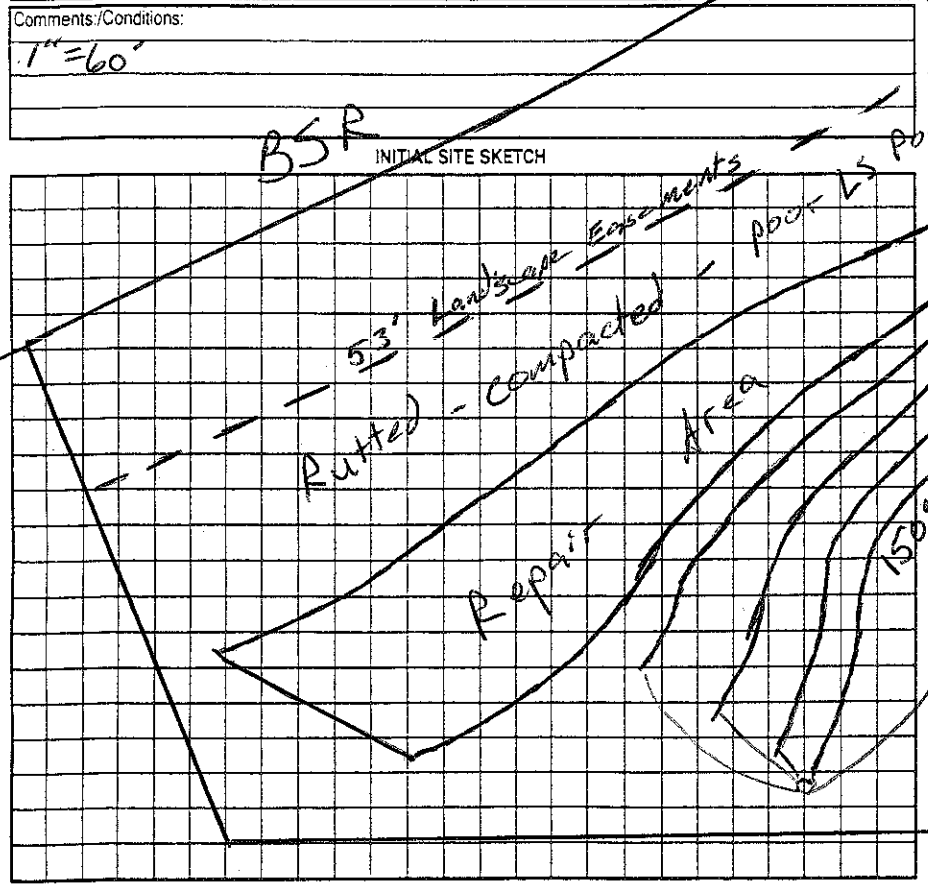

Comments:/Conditions:

AS BUILT SKETCH

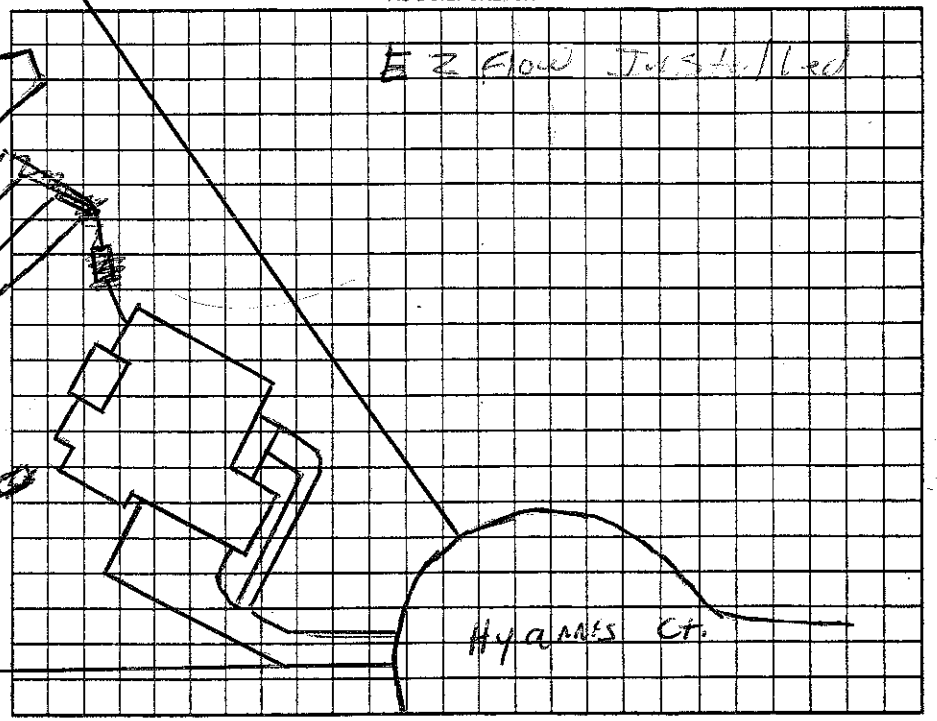

Permit can be suspended or revoked if any false information is supplied toward securing the permit/any unauthorized changes are made to the site/any unauthorized changes are made in the installation of the system. Improvement Permit with plat valid without expiration ☐ Improvement Permit with site plan valid for sixty months ☒ Authorization to Construct is valid for a period equal to that of Improvement Permit – not to exceed sixty months.

Signed: date 12/2/05 Installed by: Hallman

Improvement Permit by: RS date 11/28/05 Operation Permit by: RS date 9/12/06

Authorization to Construct by: RS date 11/28/05 Existing System Inspection by: date

HEALTH DEPT. COPY: WHITE OWNER COPY (FINAL): YELLOW OWNER COPY (INITIAL): PINK