IREDELL COUNTY HEALTH DEPARTMENT

STATESVILLE 704-878-5305 MOORESVILLE 704-664-5281

IMPROVEMENT PERMIT / AUTHORIZATION TO CONSTRUCT / OPERATION PERMIT / EXISTING SYSTEM INSPECT

PERMIT# 109601 PIN# 4624-27-5705.1170 4624486431 DATE 6/23/05

OWNER OR CONTRACTOR Lifestyle Custom Homes PHONE: Business 980-721-0917 Home

ADDRESS 65 McComby St Charlotte NC

LOCATION BSR, TL Torrence chapel, TL Shelburne, TL Cape Cod, TL Hyannis, at end

SUBDIVISION Point BLOCK / SECTION 11 LOT 1170 LOT AREA 63,422 Ft² SITE CLASS. PS DESIGN FLOW 600 L.T.A.R. 0.225

Septic Tank: 1500 Gallons; STB 338 Date 7/24/05
Pump Tank: 1500 Gallons; PT 477 Date 9/16/05
Pump Make: Model Serial No.
Nitrification Field: No Fields 1 Square Feet 1995 Linear Feet 665
No Lines 5@133' Trench Width 36" Max Trench Bottom Depth 48" Gravel Depth —

☒ New System ☐ Repair System Type: I, II, III, IV, V, VI
System Description: PM 25% Reduction 59 mc
Repair System Description:
Maintenance Agreement Required: ☐ Yes ☒ No

☒ House/Mod. Home No. Bedrooms 5
☐ Mobile Home No. Bathrooms
☐ Business No. Employees
☐ Other


☐ Slab ☒ Crawl Space ☐ Basement w/plumbing ☐ Basement wo/plumbing

Water Supply: ☐ Individual ☐ Public ☒ Community

Comments:/Conditions: 42" min. Trench Bottom
1"=60'

Comments:/Conditions: EZFLOW INSTALLED

INITIAL SITE SKETCH

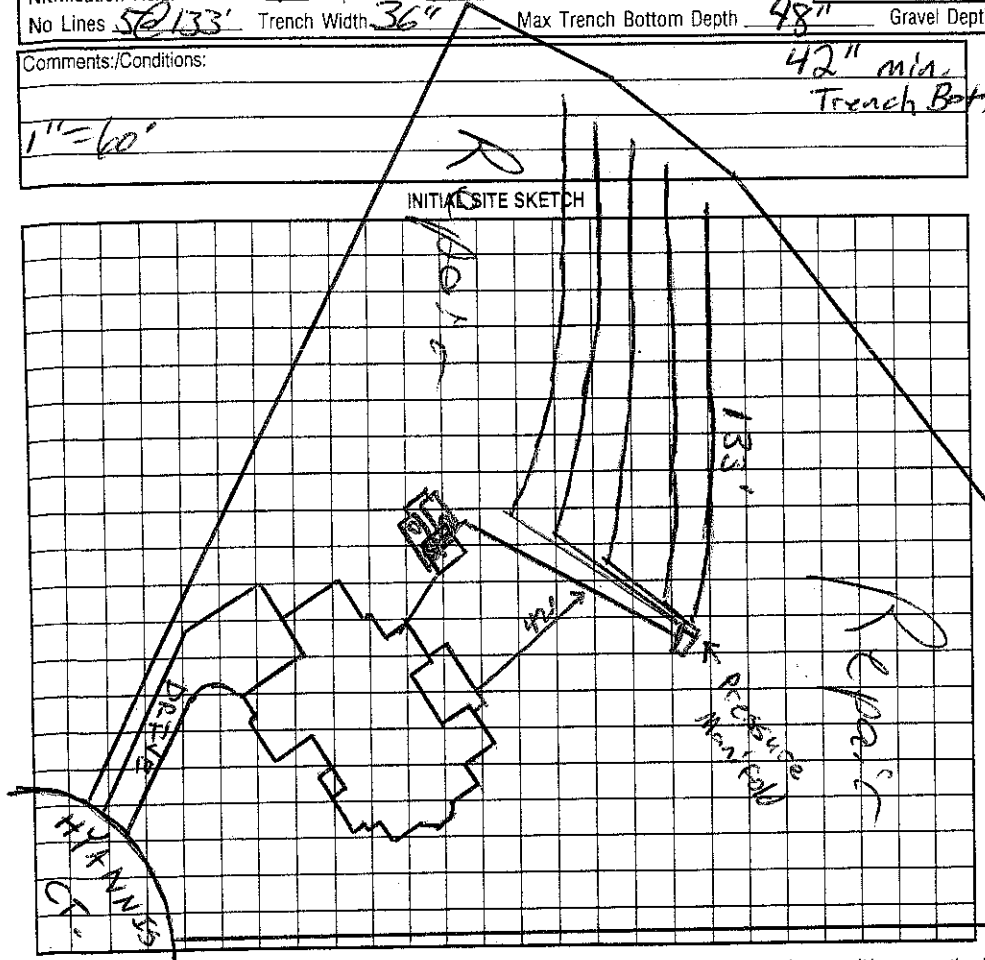

AS BUILT SKETCH

Permit can be suspended or revoked if any false information is supplied toward securing the permit/any unauthorized changes are made to the site/any unauthorized changes are made in the installation of the system. Improvement Permit with plat valid without expiration. Improvement Permit with site plan valid for sixty months. Authorization to Construct is valid for a period equal to that of Improvement Permit – not to exceed sixty months.

Signed: date

Improvement Permit by: RS date 6/23/05

Authorization to Construct by: RS date 6/25/05

Installed by: Hallman Const.

Operation Permit by: RS date 9/22/05

Existing System Inspection by: date

HEALTH DEPT. COPY: WHITE OWNER COPY (FINAL): YELLOW OWNER COPY (INITIAL): PINK