Old # 109607

IREDELL COUNTY HEALTH DEPARTMENT

Statesville Office (704) 878-5305 Mooresville Office (704) 660-3625 PERMIT # 179761

IMPROVEMENT PERMIT / AUTHORIZATION TO CONSTRUCT / OPERATION PERMIT / EXISTING SYSTEM

PIN # 4624-48-7064

APPLICANT: ARH Models LLC. APPLICANT ADDRESS: 13922 58TH St. N. Clearwater FL.

SITE ADDRESS: 147 Torrence Chapel Rd - Mocksville PHONE: ALT. PHONE:

SITE DIRECTIONS: BSR, TL Torrence Chapel, on L

SUBDIVISION: The Point on Norman SECTION: 11 LOT # 1182 LOT AREA: 1.636 AC DESIGN FLOW: 480 L.T.A.R.: .25

Septic Tank	1500 (gal)	STB	338	Date	6-22-14	☑ New System ☐ Repair ☐ Expansion	System Type: I II (III) IV V VI	☑ Residence	No. Bedrooms 4
Pump Tank	(gal)	PT		Date		System Description:	25% Reduction	☐ Business	No. Persons
Pump Make		Model		Serial #		Repair System Description:	Panel Block	☐ Other	No. Employees
# Nitrification Fields	1	# Lines	6	Linear Ft:	400'	Maintenance Agreement Required:	☐ YES ☑ NO	☐ Slab	☑ Crawl Space
Trench Width	36"	Max. Trench Bottom Depth	36"	Gravel Depth	—	☑ GRAVITY	☐ PRESSURE	☐ Basement w/plumbing	☐ Basement w/o plumbing

Water Supply: ☐ Private ☐ Public ☑ Community

Comments / Conditions: Top Seam Tank

INITIAL SITE SKETCH

See Plan From Michael Athanas & Associates

AS BUILT SKETCH

Permit can be suspended or revoked if any false information is supplied toward securing the permit / any unauthorized changes are made to the site / any unauthorized changes are made in the installation of the system. **CONTACT A LOCATOR SERVICE PRIOR TO ANY EXCAVATION**

☐ **IMPROVEMENT PERMIT** *with plat valid without expiration.* ☑ **IMPROVEMENT PERMIT** *with site plan valid for 60 mos.* ☑ **AUTHORIZATION TO CONSTRUCT** *valid for period equal to IMPROVEMENT PERMIT--not to exceed 60 mo.*

Owner / Applicant Signature: Rachel Stevenson/Blueford Date: 12/31/15

IMPROVEMENT PERMIT by: [signature] APPROVED Date: DEC 17 2015


AUTHORIZATION TO CONSTRUCT by: [signature] Date: 1-14-16

Installed by: Abernathy

OPERATION PERMIT by: [signature] Date: 8-25-16

Existing System Inspected by: Date:

Health Dept. Copy - WHITE Applicant (Final Approval) - YELLOW Applicant (Conditional Approval) - PINK

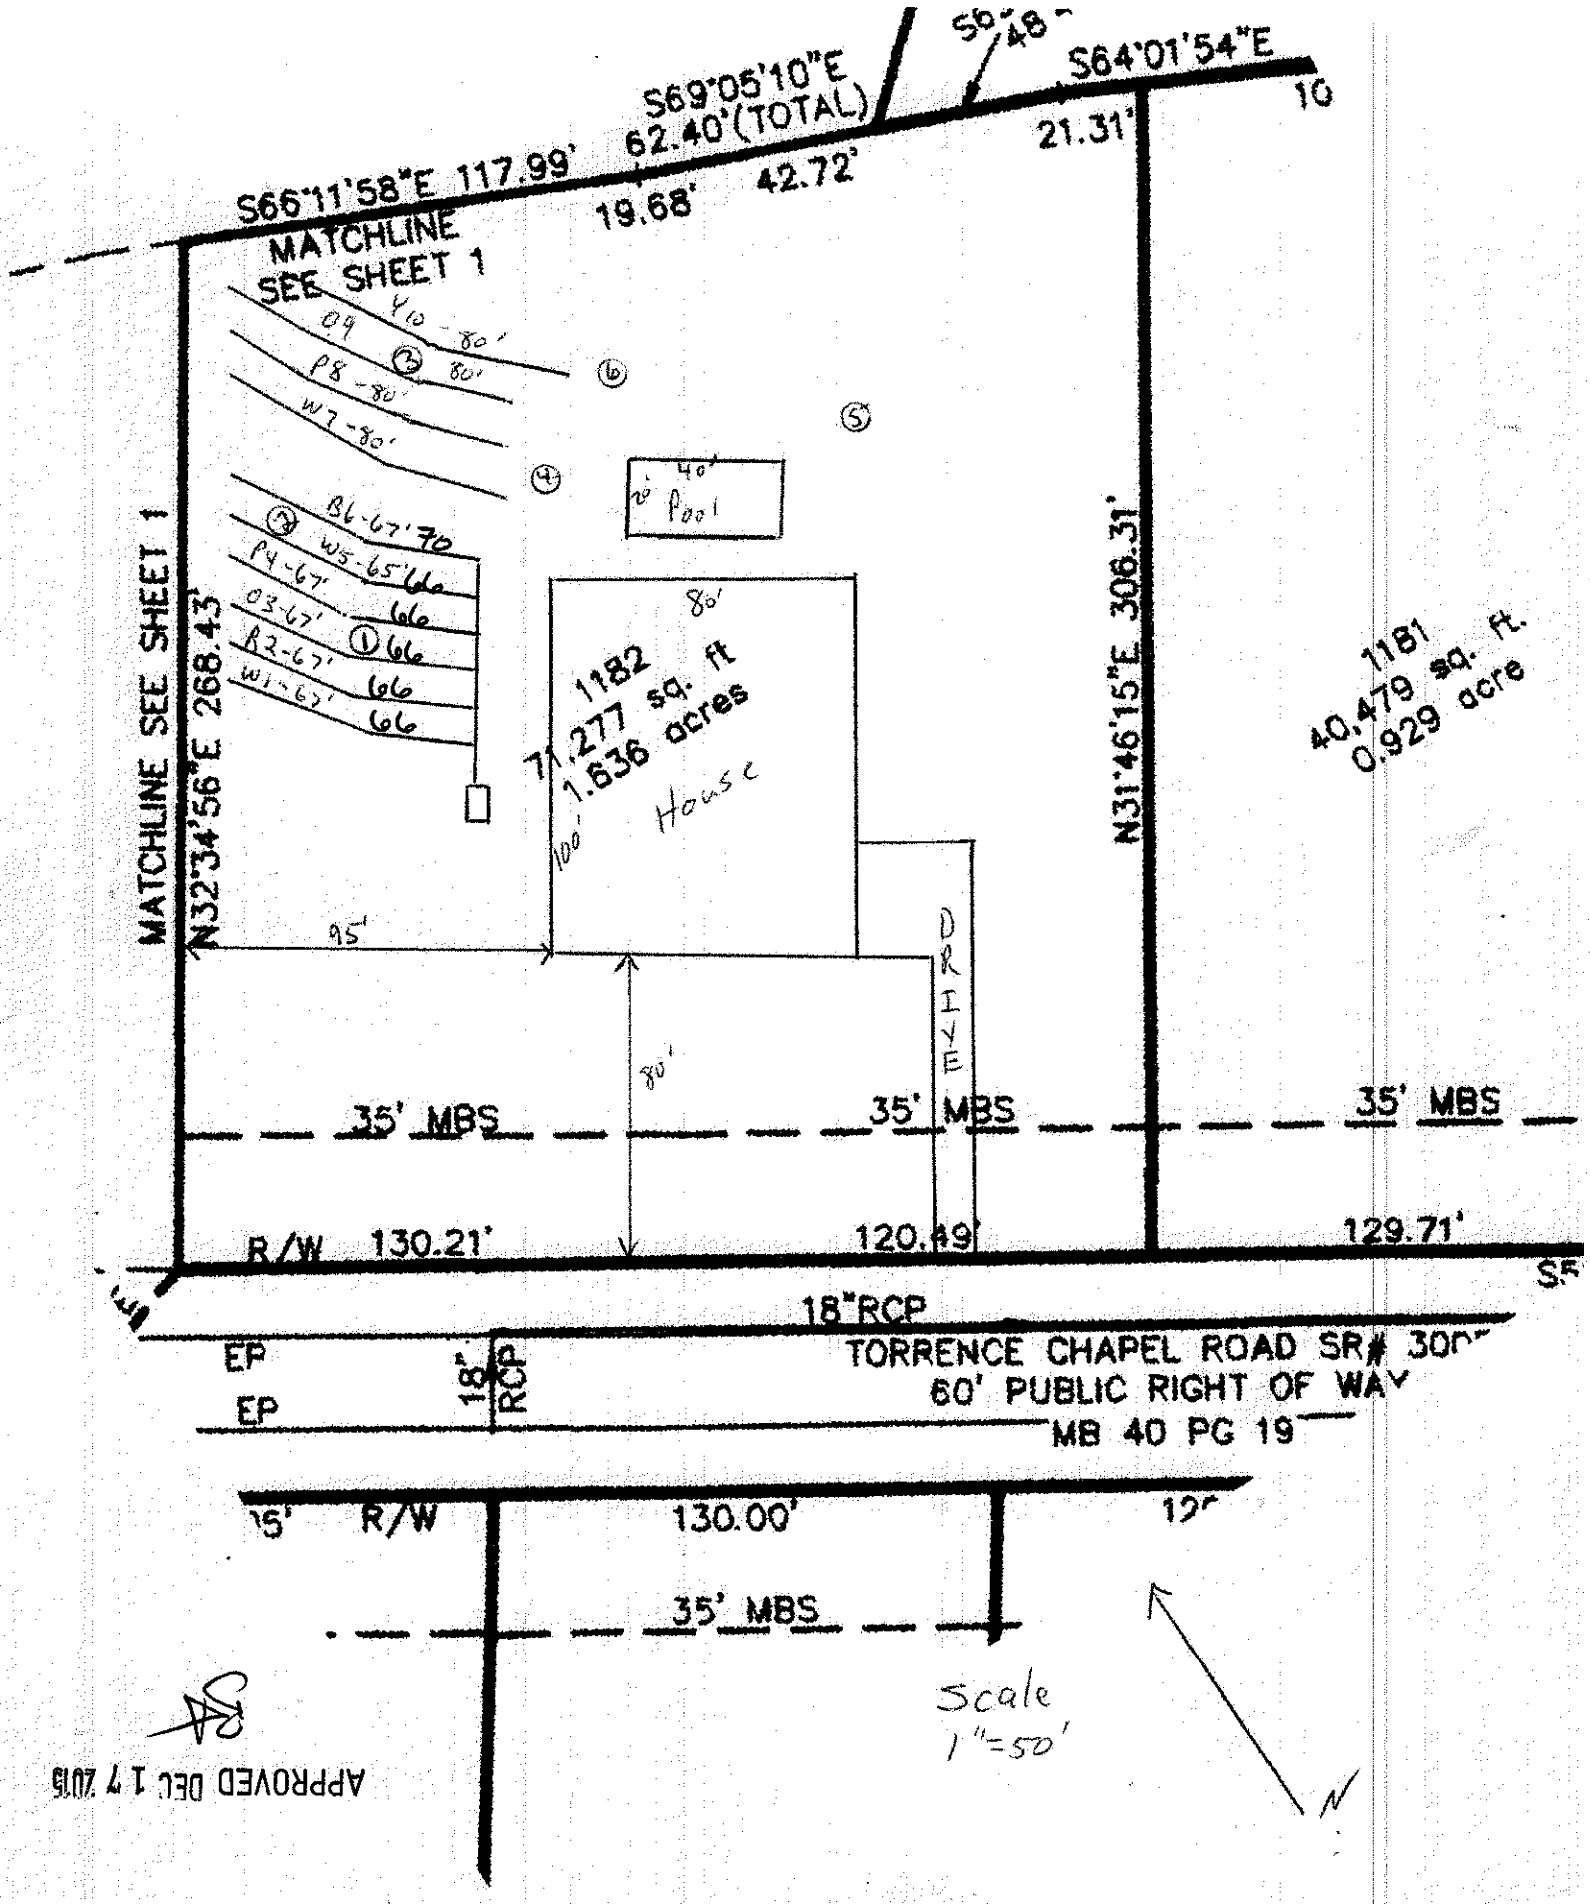

APPROVED DEC 17 2015