3:30

IREDELL COUNTY HEALTH DEPARTMENT

STATESVILLE 704-878-5305 MOORESVILLE 704-664-5281

IMPROVEMENT PERMIT / AUTHORIZATION TO CONSTRUCT / OPERATION PERMIT / EXISTING SYSTEM INSPECTION

PERMIT# 109597 PIN# ~~4624-27-5705~~ .1168 4624-48-7707 DATE Feb 5, 03

OWNER OR CONTRACTOR Crescent Resources c/o // The Point or Norman Simonini PHONE: Business _____ Home _____

ADDRESS 2214 Brawley Sch Rd., Mooresville, N.C. 28117

LOCATION Brawley Sch Rd. TL Torrence Chapel TL Shelbourne TL Cape Cod TL Hyannis Ct. on Right AT END

SUBDIVISION The Point BLOCK / SECTION 11 LOT 1168 LOT AREA 57792 ft² SITE CLASS. PS DESIGN FLOW 480 gpd L.T.A.R. .25

Septic Tank: 1000 Gallons; STB 338 Date 5-8-05
Pump Tank: 1000 Gallons; PT 283 Date 4-11-05
Pump Make: Goulds Model 1/3HP WE0312M1U Motor No. _____
Nitrification Field: No Fields 1 Square Feet 640/960 Linear Feet 320
No Lines 4 Trench Width 24" MIN 8'oc' Max Trench Bottom Depth 36" Gravel Depth N/A

☑ New System ☐ Repair System Type: I II III IV V VI
System Description: LPPPBPS
Repair System Description: LPPPBPS
Maintenance Agreement Required: ☑ Yes ☐ No


☑ House/Mod. Home No. Bedrooms 4
☐ Mobile Home No. Bathrooms 4
☐ Business No. Employees _____
☐ Other _____
☐ Slab ☑ Crawl Space ☐ Basement w/plumbing ☐ Basement wo/plumbing

Water Supply: ☐ Individual ☑ Public ☑ Community

Comments:/Conditions: OR 36" WMP 9'oc
Reviewed plans; essentially in compliance with Improvement Permit. TMP

Comments:/Conditions: Checked tanks 6/16/05
Lines Checked 6/17/05
Pressure, elect & alarm 9/20/05

INITIAL SITE SKETCH 1"=100'

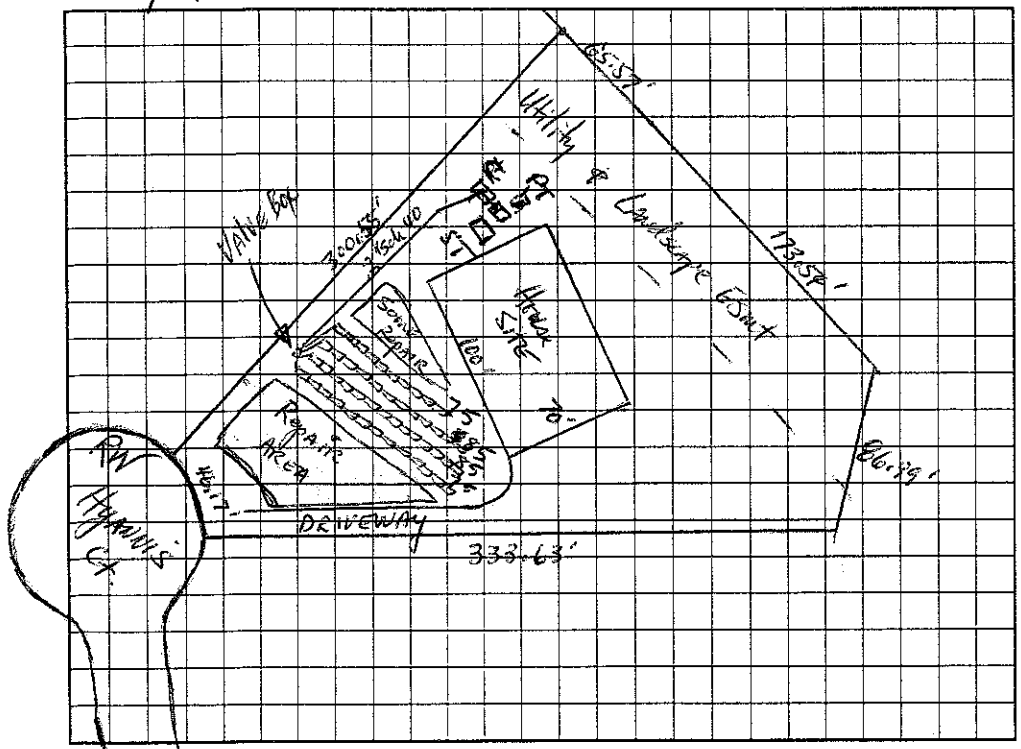

AS BUILT SKETCH

Permit can be suspended or revoked if any false information is supplied toward securing the permit/any unauthorized changes are made to the site/any unauthorized changes are made in the installation of the system. Improvement Permit with plat valid without expiration. Improvement Permit with site plan valid for sixty months. Authorization to Construct is valid for a period equal to that of Improvement Permit – not to exceed sixty months.

Signed: _____ date 9/8/03
Improvement Permit by: _____ date 2-5-03
Authorization to Construct by: Marina H Dotson RS date 2/24/05

Installed by: Ralph RS
Operation Permit by: Marina H Dotson RS date 9/20/05
Existing System Inspection by: _____ date _____

HEALTH DEPT. COPY: WHITE OWNER COPY (FINAL): YELLOW OWNER COPY (INITIAL): PINK