IREDELL COUNTY HEALTH DEPARTMENT

STATESVILLE 704-878-5305 MOORESVILLE 704-664-5281

IMPROVEMENT PERMIT / AUTHORIZATION TO CONSTRUCT / OPERATION PERMIT / EXISTING SYSTEM INSPECTION

PERMIT# 109602 PIN# 4624275705 DATE 8-1-05

OWNER OR CONTRACTOR Simonini Builders PHONE: Business Home

ADDRESS

LOCATION Brawley School Rd TL Torrence Chapel TL Shelburne TL Cape Cod TL Hyannis at end

SUBDIVISION The Point BLOCK / SECTION LOT 117 LOT AREA 53652 SITE CLASS. PS DESIGN FLOW 480 gpd L.T.A.R. .25 on left

Septic Tank: 1500 Gallons; STB 338 Date 6-5-05
Pump Tank: 1000 Gallons; PT 283 Date 6-11-05
Pump Make: Myers Model ME 5052 Serial No. 253270
Nitrification Field: No. Fields 1 Square Feet 960 Linear Feet 320
No. Lines 4 Trench Width 36" Max Trench Bottom Depth 36" Gravel Depth N/A

☐ New System ☐ Repair System Type: I, II, III, (IV), V, VI
System Description: Pump-LP- Panel Blk
Repair System Description: Same
Maintenance Agreement Required: ☒ Yes ☐ No

☒ House/Mod. Home ☐ Mobile Home ☐ Business ☐ Other
No. Bedrooms 4 No. Bathrooms 4 No. Employees
☐ Slab ☒ Crawl Space ☐ Basement w/plumbing ☐ Basement wo/plumbing


Water Supply: ☐ Individual ☒ Public ☒ Community

Comments:/Conditions:


Comments:/Conditions:

Scale 1:50

INITIAL SITE SKETCH

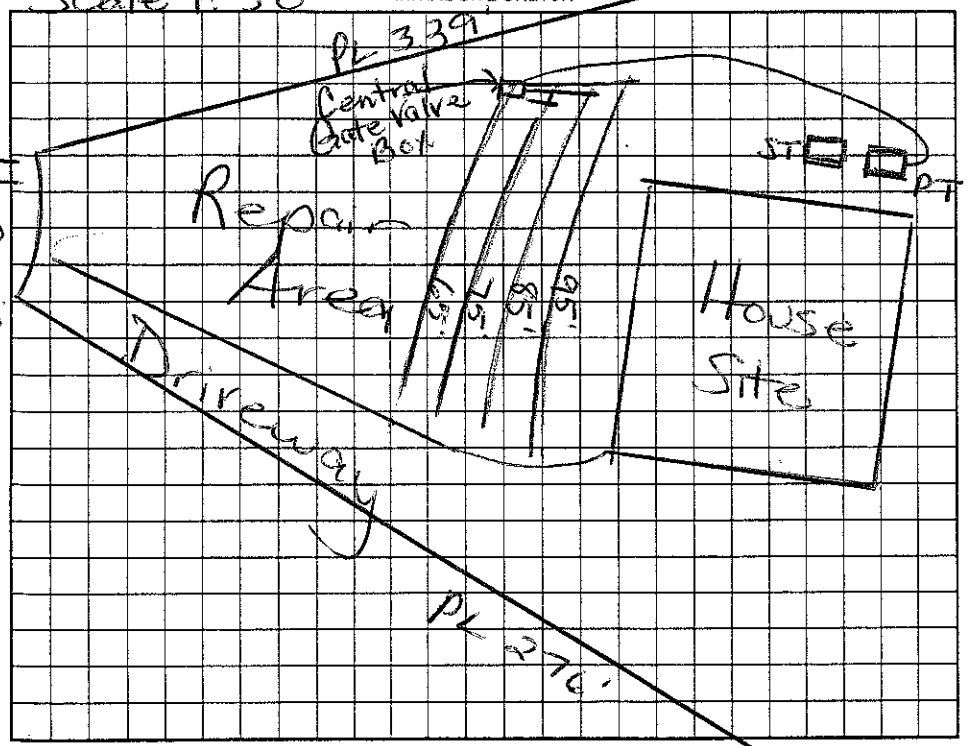

AS BUILT SKETCH

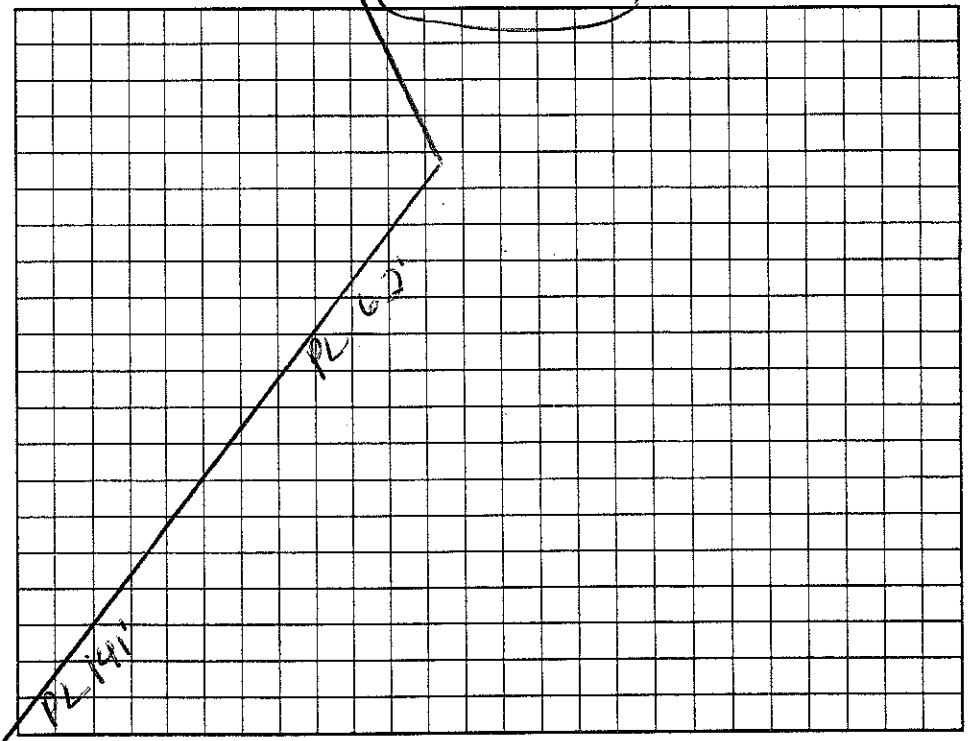

Permit can be suspended or revoked if any false information is supplied toward securing the permit/any unauthorized changes are made to the site/any unauthorized changes are made in the installation of the system. Improvement Permit with plat valid without expiration. Improvement Permit with site plan valid for sixty months. Authorization to Construct is valid for a period equal to that of Improvement Permit – not to exceed sixty months.

Signed: X M. McMillan date 1/12/06 Installed by: R & H

Improvement Permit by: Maria H Dotson RS date 1/12/06 Operation Permit by: Maria H Dotson RS date 1/12/06

Authorization to Construct by: Maria H Dotson RS date 1/12/06 Existing System Inspection by: date

HEALTH DEPT. COPY: WHITE OWNER COPY (FINAL): YELLOW OWNER COPY (INITIAL): PINK